

WATER SERVICE RECORD

2274

Name **Gerald Skinner**

Service No. **132 & 178** (2 de

Address **124 Woburn Street**

Location

Lot 51

~~RENEW~~ Renewal ~~XXXXXXXXXX~~

Com. 8-10-53


Date	Material	Amount	Total	Date	Material	Amount
7/20/53	Labor	17 33		6-10-53	Deposited \$35.00	
	10% overhead	1 73	19 06	6-29-53	Deposited \$25.00	50 00
	46' - 3/4" copper tubing @ .3629		16 69	8-10-53	Refunded	(2 00
	1 - 3/4" C x 1/2 I.W.H. stop & waste		4 00		<u>NON CHARGE</u>	48 00
	1 hr. Littlefield shovel		7 50	7/20/53	Labor	41 00
	1 hr. trucking		75		18' - 3/4" copper tubing @ .3629	6 53
			48 00		1 - 3/4" C. corp-cock	4 33
					1 - 3/4" C x 3/4" C. curb-cock	4 67
					1 - box and rod	3 90
					1 - 1/2 offset tail piece	50
					1 - 1/2 straight tail piece	50
					1 hr. trucking	75
					5 hrs. Littlefield shovel @ 7.50	37 50
					patching 16 x 3	16 00
						115 68

DATE _____

TOWN OF LEXINGTON — BOARD OF PUBLIC WORKS

WATER DIVISION

Sketch of Service Here

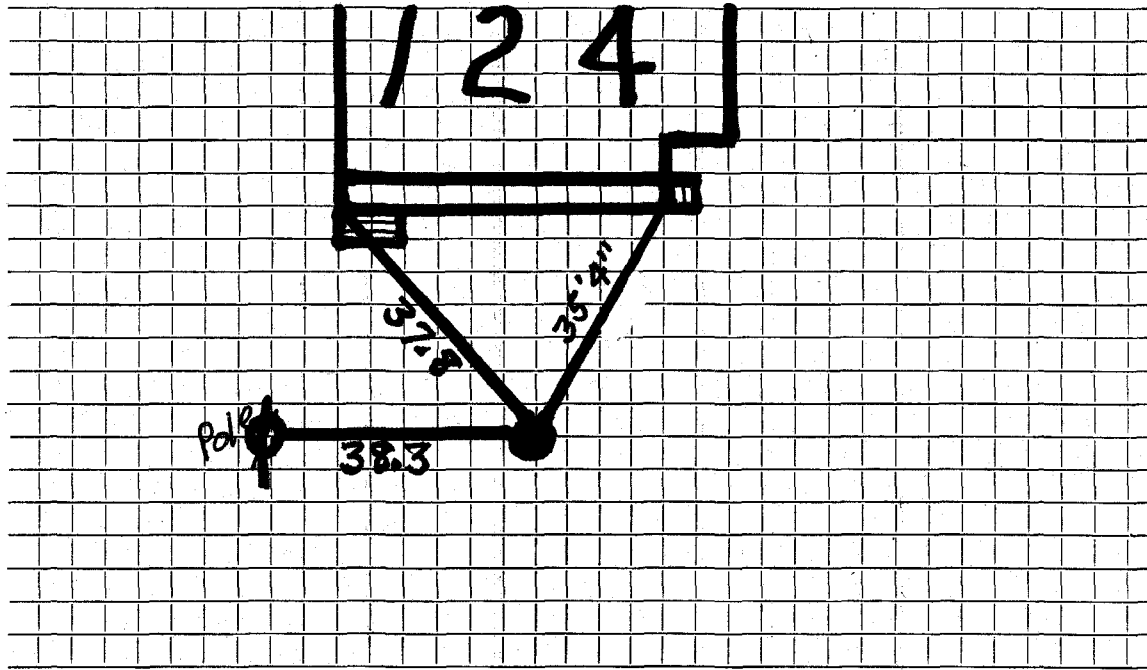

Connection made in Street. Work completed

Remarks: Tap on 16" Water main