




DATE \_\_\_\_\_

TOWN OF LEXINGTON — BOARD OF PUBLIC WORKS

WATER DIVISION

Sketch of Service Here

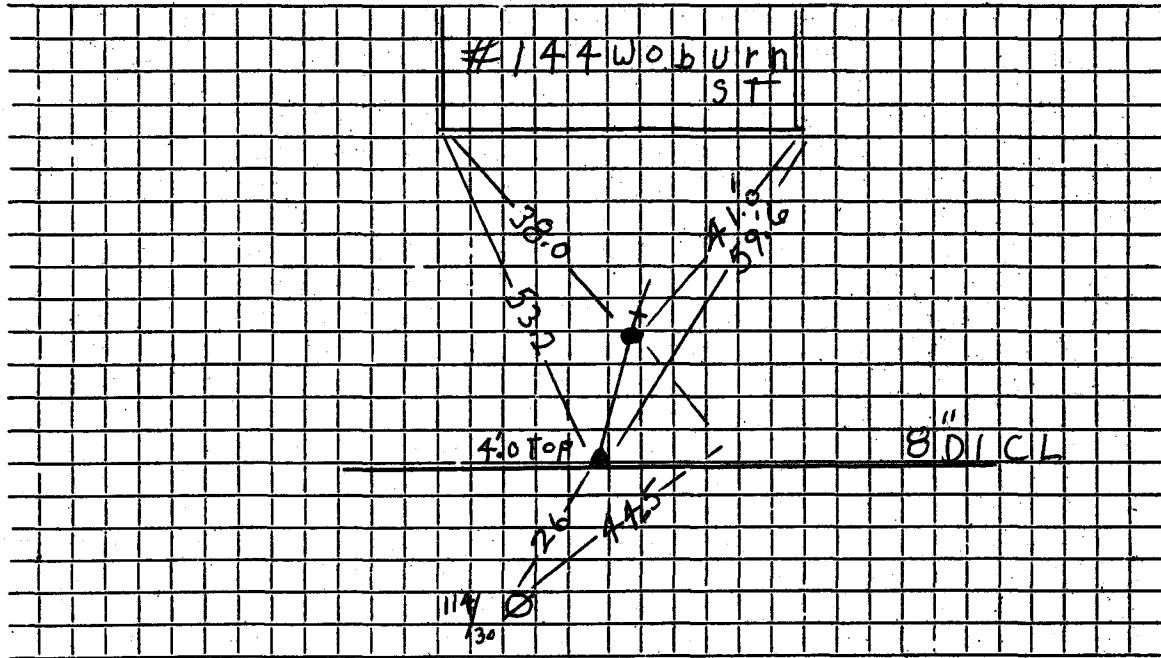

Connection made in ..... Street.

Work completed 8/29/07 Defluse.....

Remarks: 3/4 SERVICE WAS ON 16" WATER MAIN - (Killed?)