

WATER SERVICE RECORD

Name

Service No.

Address 15 Woburn St

Location

Repair—Renewal—New Service


Date	Material	Amount	Total	Date	Amount
8-2-49	69' $\frac{3}{4}$ " Copper				
	1 $\frac{3}{4}$ " C. X $\frac{1}{2}$ " I.W.H. Stop + Waste			8-2-49	
	1 $\frac{3}{4}$ " C. X $\frac{3}{4}$ " C. Union				
				17' $\frac{3}{4}$ " Copper	
				1 $\frac{3}{4}$ " C. Corp Cock	
				1 $\frac{3}{4}$ " C. X $\frac{3}{4}$ " C. Curb Cock	
				1 Box + Rod	

DATE _____

TOWN OF LEXINGTON — BOARD OF PUBLIC WORKS

WATER DIVISION

Sketch of Service Here

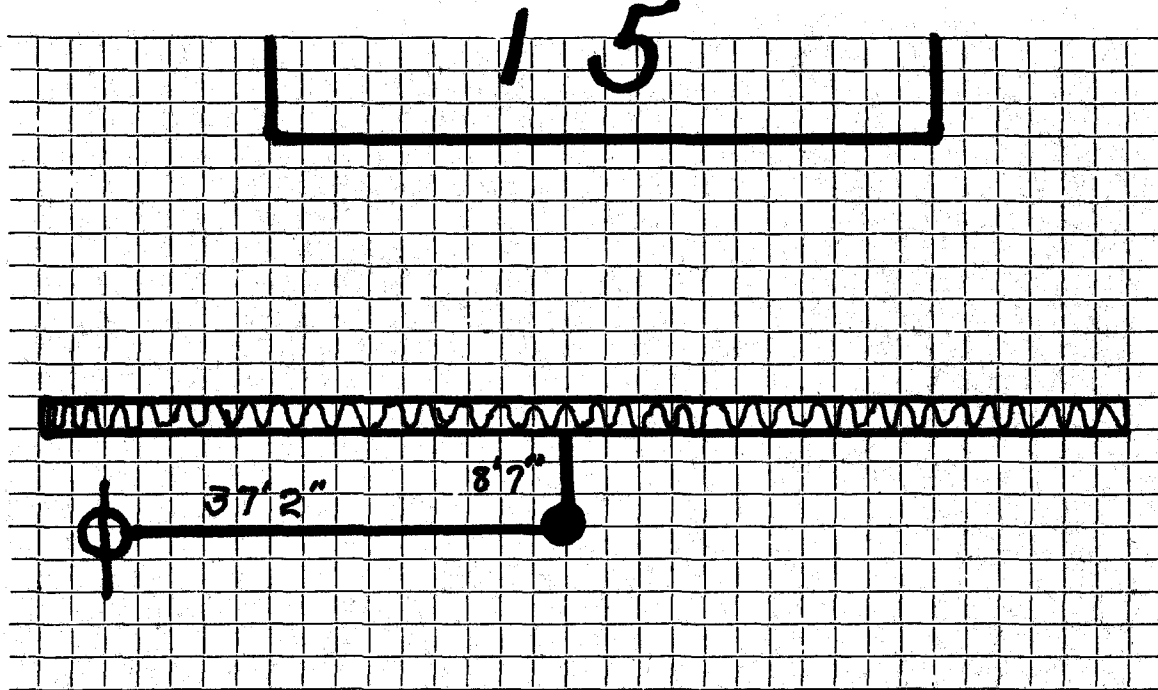

Connection made in Street. Work completed

Remarks:
.....
.....