




DATE \_\_\_\_\_

TOWN OF LEXINGTON — BOARD OF PUBLIC WORKS  
WATER DIVISION

Sketch of Service Here

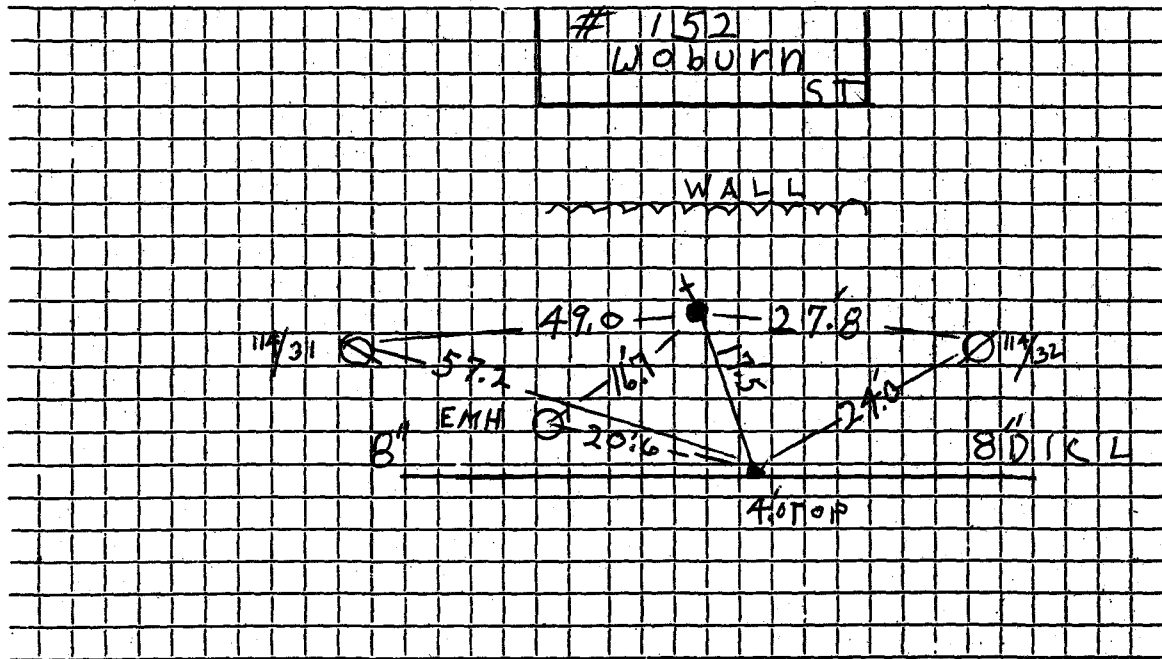

Connection made in ..... Street. Work completed 8/29/07 Def. l.c.e. ....

Remarks: Existing 3/4" Water Service sitting on top of ledge + top Elec. Duct .....

1" Curb Stop 2'-0" T.O.P. W+S. Insp. ....