

DATE _____


TOWN OF LEXINGTON — BOARD OF PUBLIC WORKS

WATER DIVISION

Sketch of Service Here

CUPP GREEN HOUSE

171

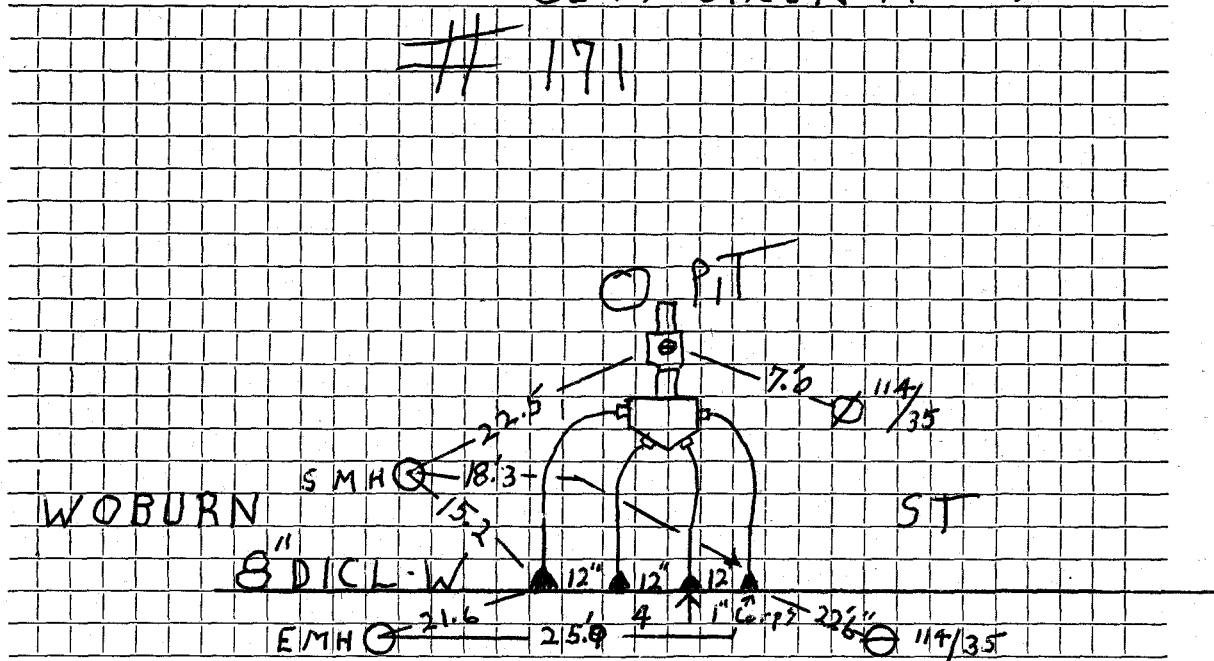

Connection made in Woburn St Street.

Work completed 9/18/07 Def. l. u. e.

Remarks: Tap's on 8" W.