


TOWN OF LEXINGTON — BOARD OF PUBLIC WORKS

WATER DIVISION

Sketch of Service Here

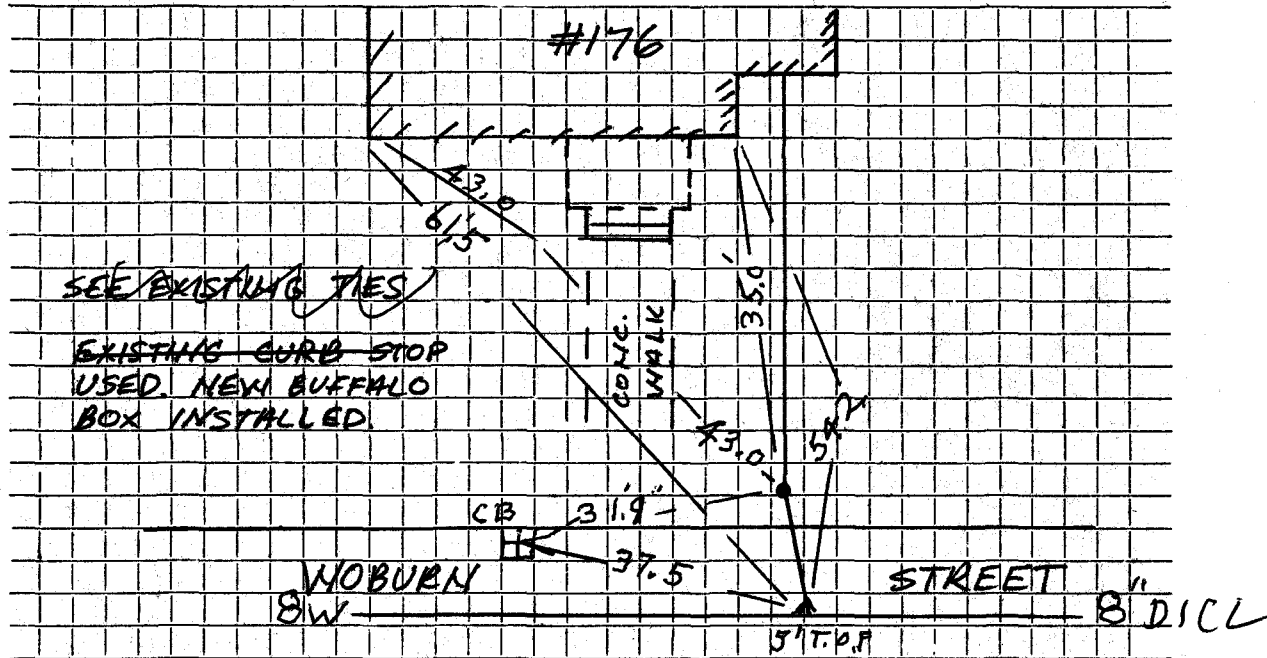

SEE EXISTING TIES
EXISTING CURB STOP
USED. NEW BUFFALO
BOX INSTALLED.

Connection made in WOBURN STREET Street. Work completed J.M. MCLAUGHLIN

Remarks: