


DATE _____

TOWN OF LEXINGTON — BOARD OF PUBLIC WORKS

WATER DIVISION

Sketch of Service Here

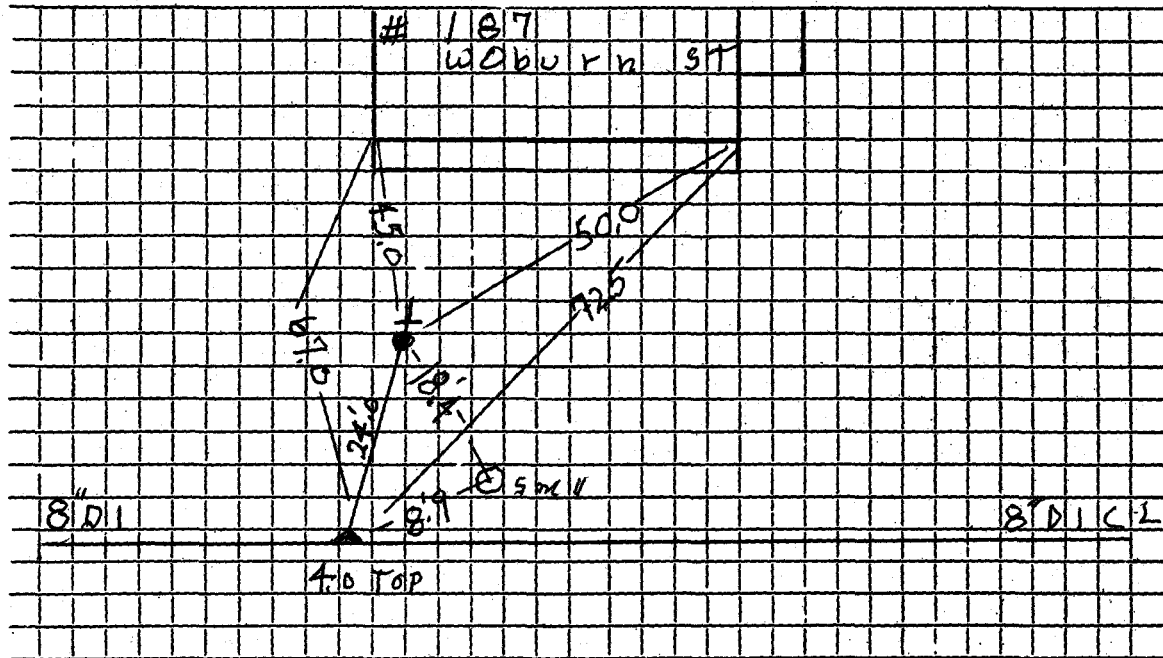

Connection made in Street.

Work completed 8/9/07 Deflect

Remarks:

.....

.....