


DATE _____

TOWN OF LEXINGTON — BOARD OF PUBLIC WORKS

WATER DIVISION

Sketch of Service Here

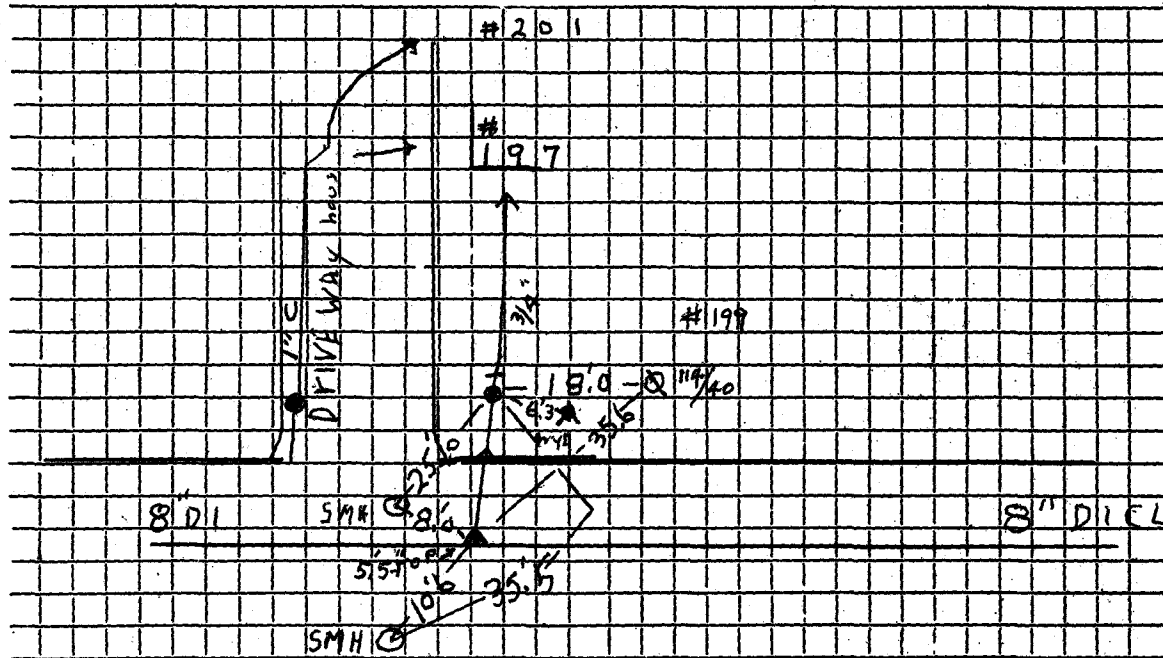

Connection made in 8" W.M. Woburn ST Street.

Work completed 8/8/07 Def. Lic. x

Remarks:

.....

.....