

WATER SERVICE RECORD

Name Jon P. McCarthy

Service No. 71 (1976)

Address 201 Woburn St.

Location

AUG 8 1977

Repair—Renewal—New Service

D.G. Construction


LOT 7B

Date		Material	Amount	Total	Date	Amount
6/24/77		Labor	16.75		6/24/77	Deposit 300.00
		10%OH	1.67	18.42	8/8/77	Refund 170.91
	17'	1" Copper @ .83		14.11		<u>129.59</u>
	1	1" Corp.		16.69		
	1	1" Curb.		20.54		
	1	Box and Rod		13.41		
	½	Ton Cold Patch		4.42		
		Hot Top 7' X 9'		42.00		
				129.59		

DATE _____

TOWN OF LEXINGTON — BOARD OF PUBLIC WORKS
WATER DIVISION

Sketch of Service Here

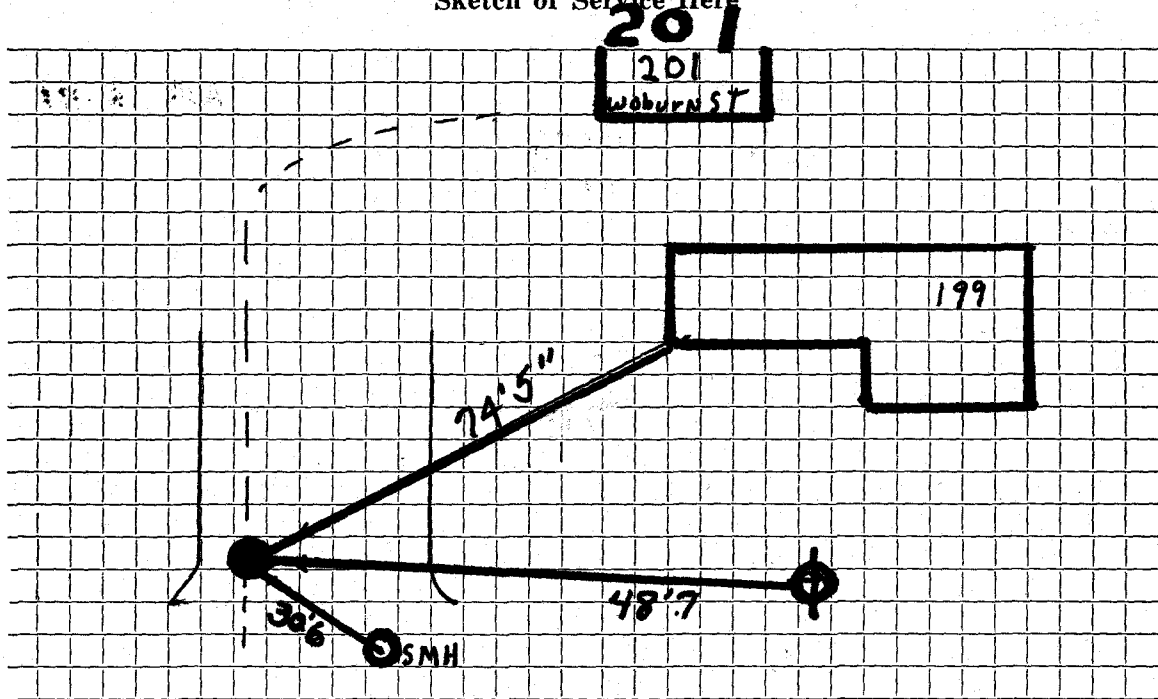

Connection made in 16" W.M. Woburn St Street. Work completed

Remarks: Shut off for 201 Woburn St.