


Water Service Tie Card  
**TOWN OF LEXINGTON**

**273 Woburn St**

MASSACHUSETTS

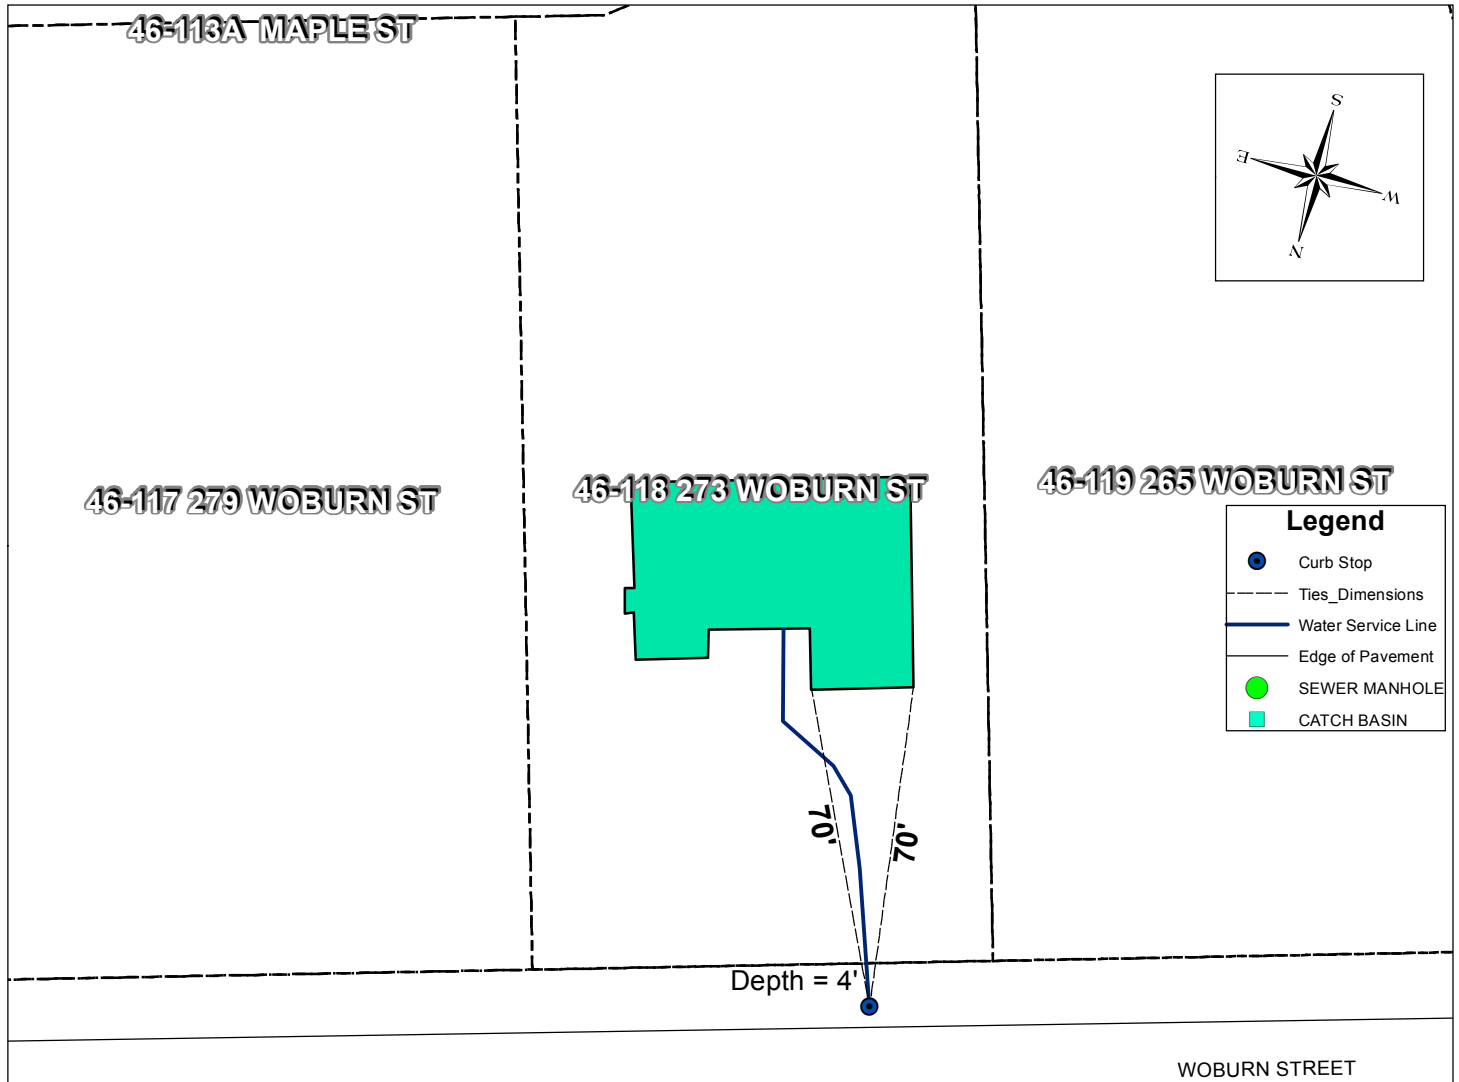

Address	Map and Lot	Permit Number	Contractor Name	Inspector
273 Woburn St	46-118	6069	McLaughlin, James M. Inc.	msprague
Date	Material	Depth of Cover	Amount	
3/19/2015	1" Curb Valve and Buffalo Box		1	
	1" Copper type "k"		90 ft	
Type of work completed				

New 1" water service to house from curb stop. New house on lot old house removed.