


TOWN OF LEXINGTON - BOARD OF PUBLIC WORKS
 WATER DIVISION

Date: 7/20/21

SKETCH OF SERVICE HERE

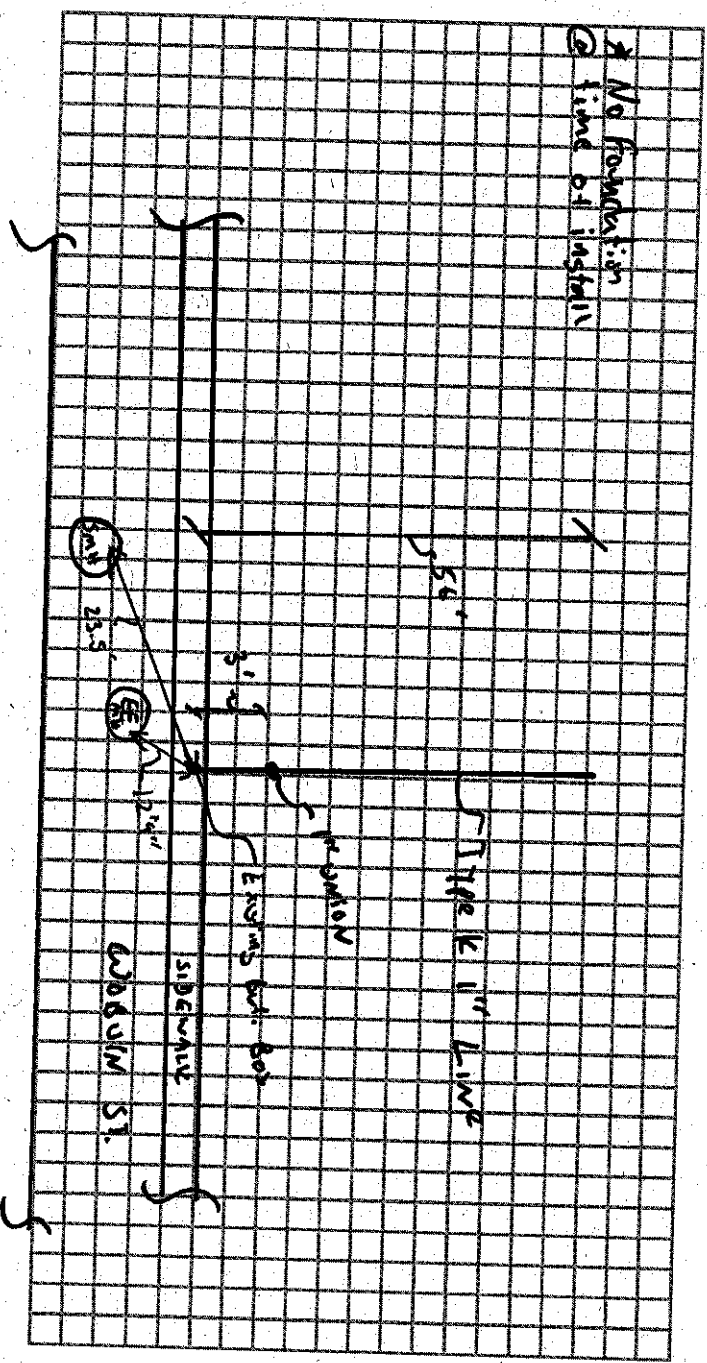

Connection made in: Waburn

Street: _____

Work completed: _____

Remarks:

* tree in existing 1" line

* No foundation @ time of install

Address 286 WOBURN ST

Location

Repair - Renewal - New Service

Date	Material	Amount	Total	Date		A
7/21	Buffalo Box	①				
	1" curb stop	①				
	CAMS. BRASS					
	1" BRASS UNION	①				
	1" Type K Copper pipe	- 56'				

