


DATE _____

TOWN OF LEXINGTON — BOARD OF PUBLIC WORKS
WATER DIVISION

Sketch of Service Here

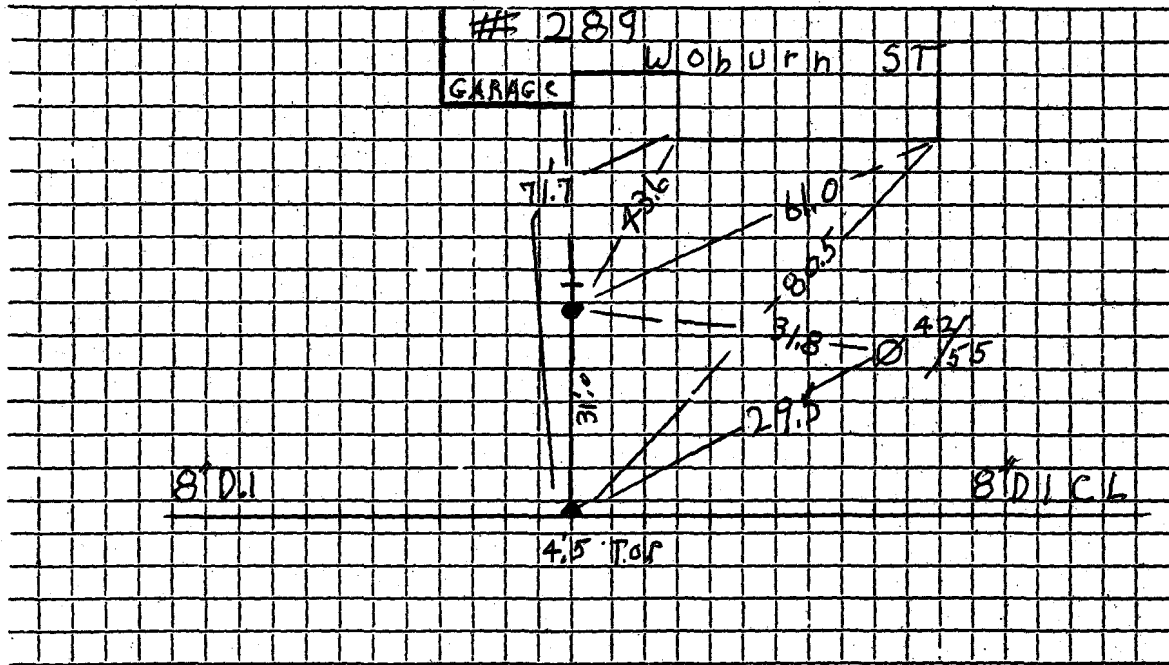

Connection made in Street.

Work completed *7/26/07 Deffen*

Remarks:
.....
.....