


DATE _____

TOWN OF LEXINGTON — BOARD OF PUBLIC WORKS

WATER DIVISION

Sketch of Service Here

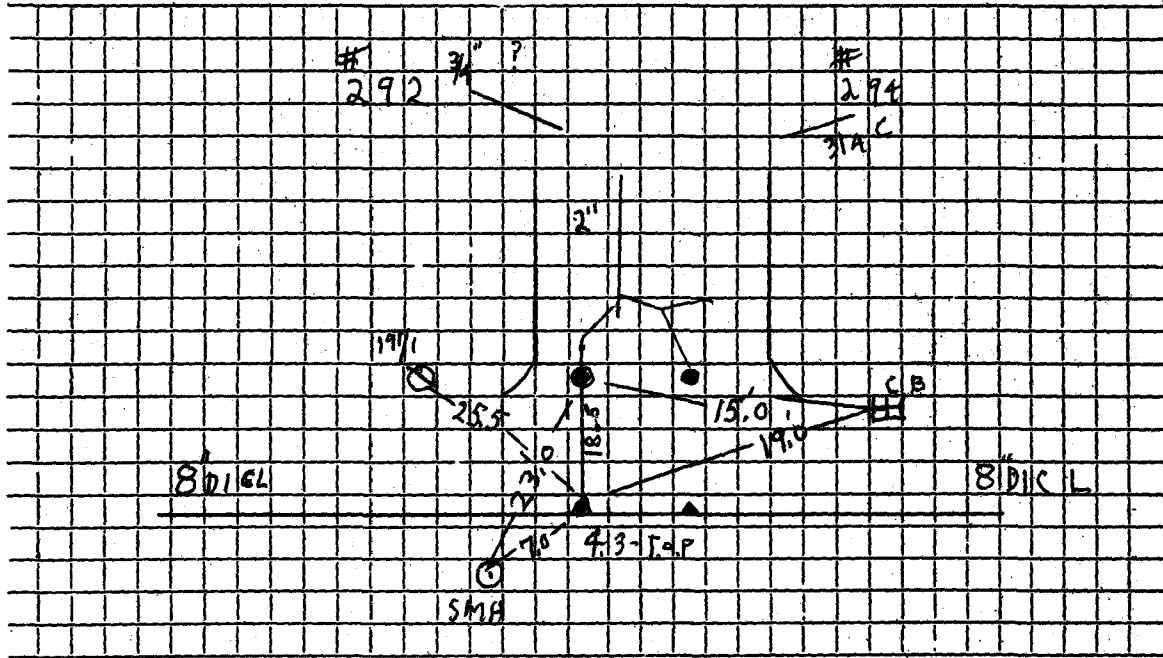

Connection made in Street. Work completed 7/26/07 Def. l. c. e.

Remarks: 2" Iron feed both 293 & 294
.....
.....