

WATER SERVICE RECORD

Name

Service No.

Address 294 Woburn ST

Location

Lot 23 + 24 ^{Right of Way}

Repair—Renewal—New Service


Date		Material	Amount	Total	Date	Deflic x	Amount
9/19/47	78'	3/4 Copper			7/26/07	16.5	1" Copper
		3/4 x 1/2 S & W				2	1" Corp's
	1	3/4 Union (3 part)				2	1" Curbs Stop
		connected to 2"					2" x 1" x 1" Branch Connection
							Share with # 292
							Services connected to 2
							2" Iron in right of way

DATE _____

TOWN OF LEXINGTON — BOARD OF PUBLIC WORKS

WATER DIVISION

Sketch of Service Here

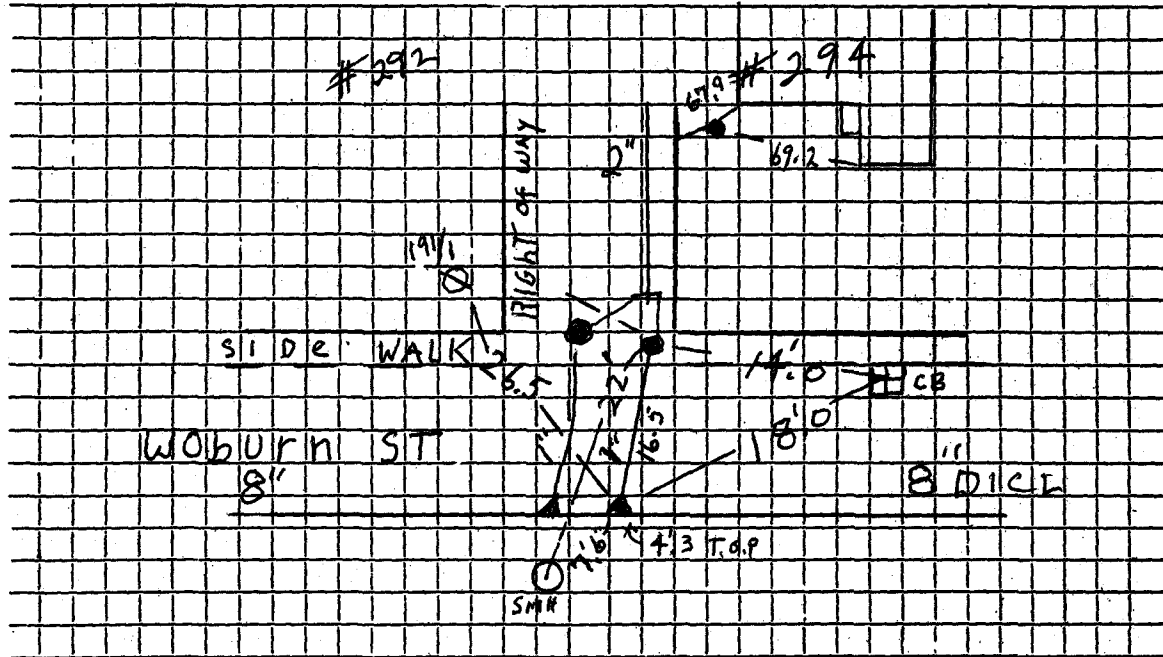

Connection made in Street.

Work completed 7/26/07 Deftice

Remarks: 2" Iron Feeds both 292 & 294.