


DATE _____

TOWN OF LEXINGTON — BOARD OF PUBLIC WORKS

WATER DIVISION

Sketch of Service Here

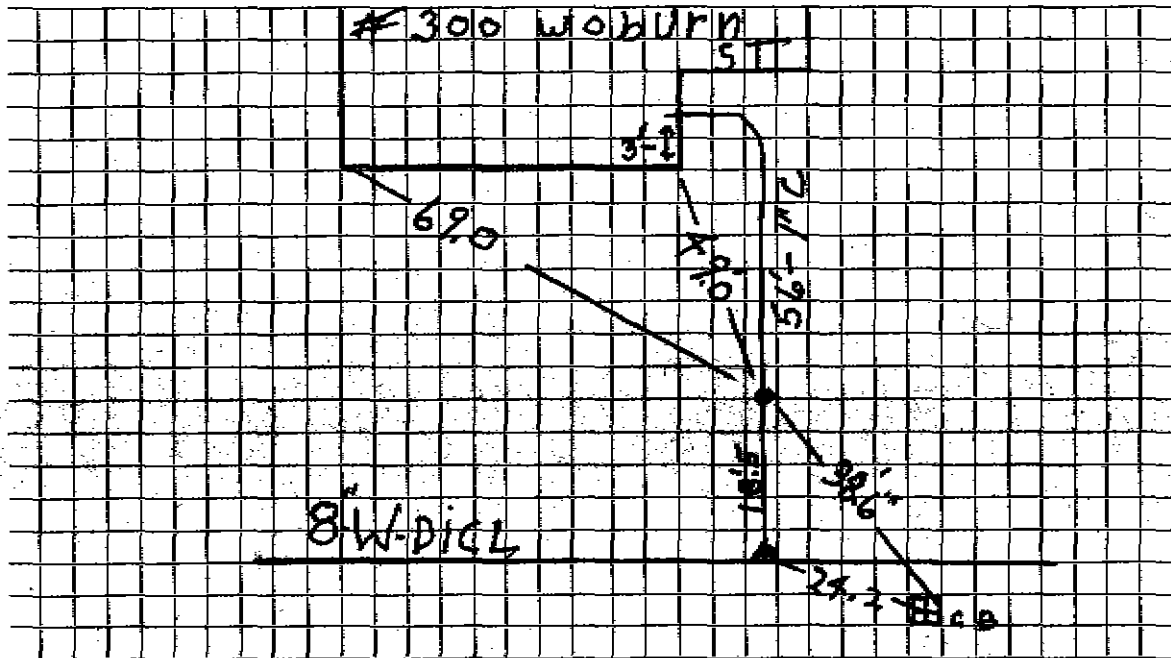

Connection made in Street. Work completed

Remarks:


.....

.....

Owner # Lex-Hab Contractor # J.M. McLaughlin, Inc.
Address # 300 Waburn St. Date # 3/6/09 PG #
Permit # 3198

LOT 26


water

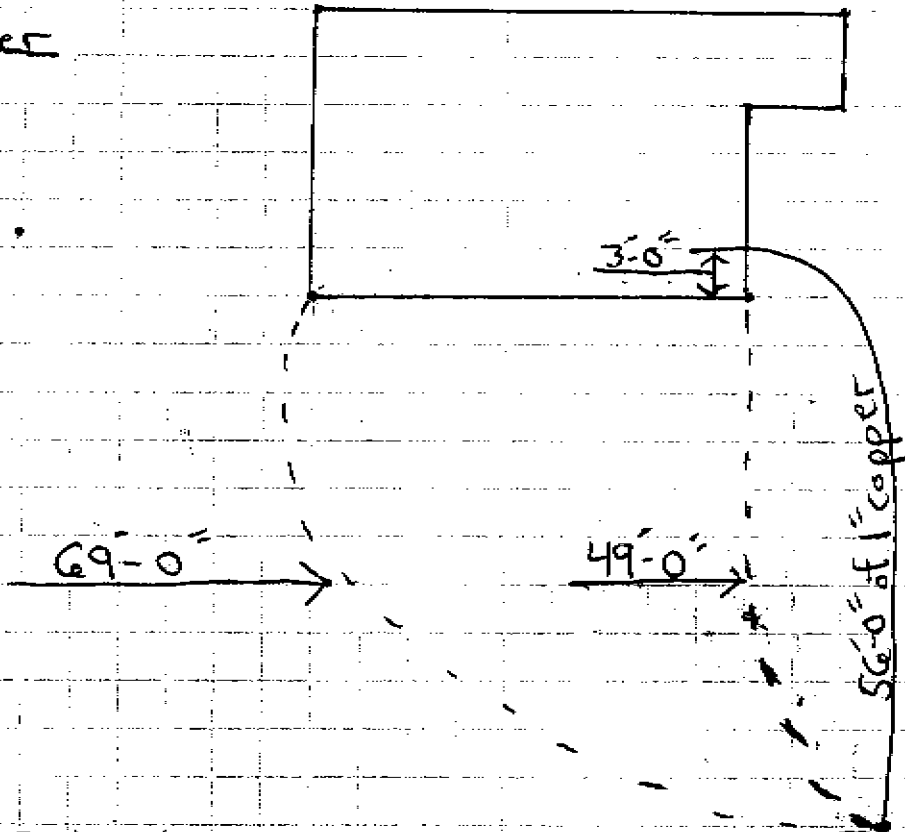

T.C.M.

* Tied onto existing 1" curb stop + buffer box

* Installed C=AC + C=PVC Franco
 Sewer stub In - 8'-0" down.

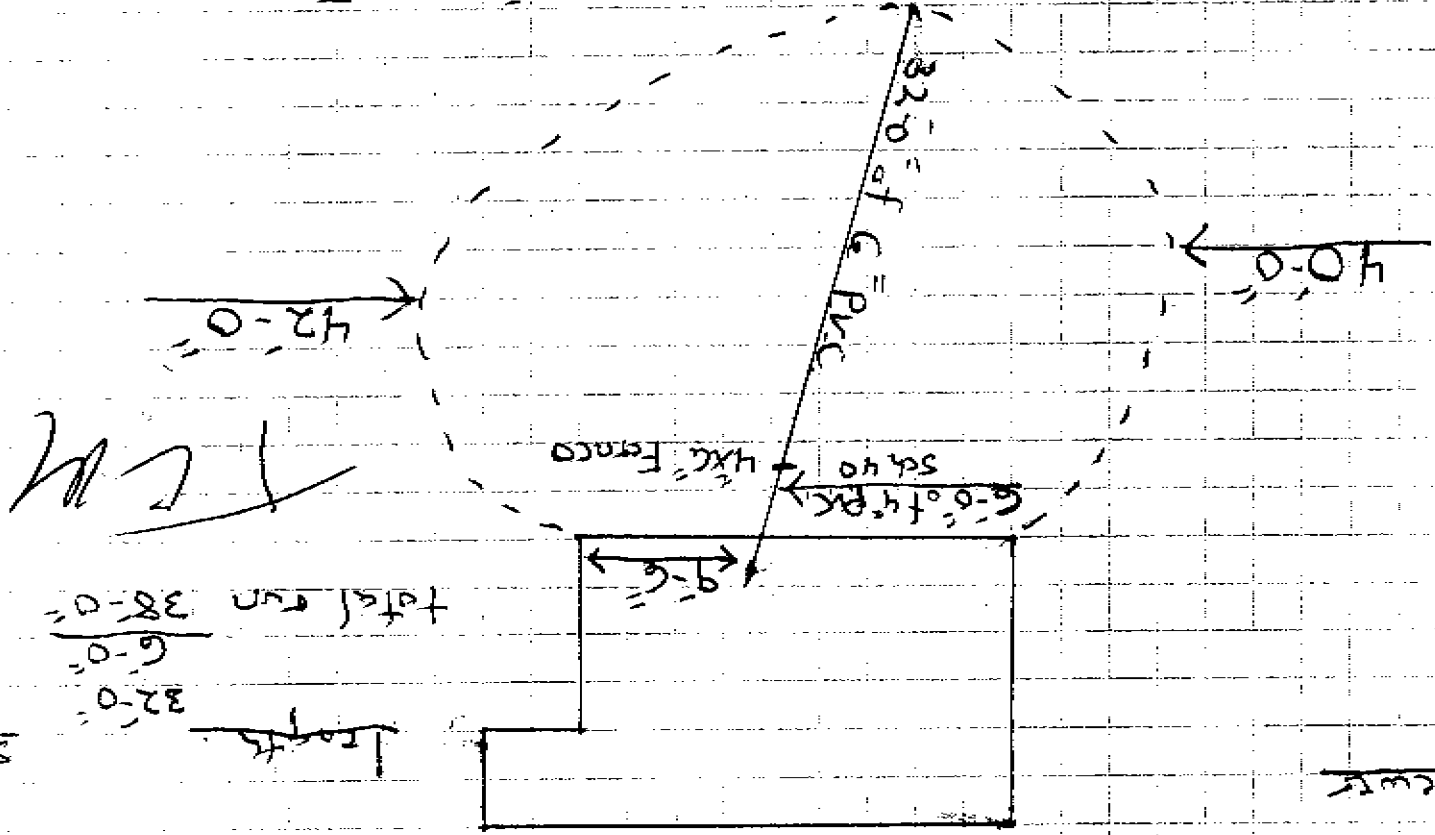

Lengths
 32'-0"
 6'-0"
 38'-0"
 Total run

SEWER