




TOWN OF LEXINGTON - BOARD OF PUBLIC WORKS  
WATER DIVISION

SKETCH OF SERVICE HERE

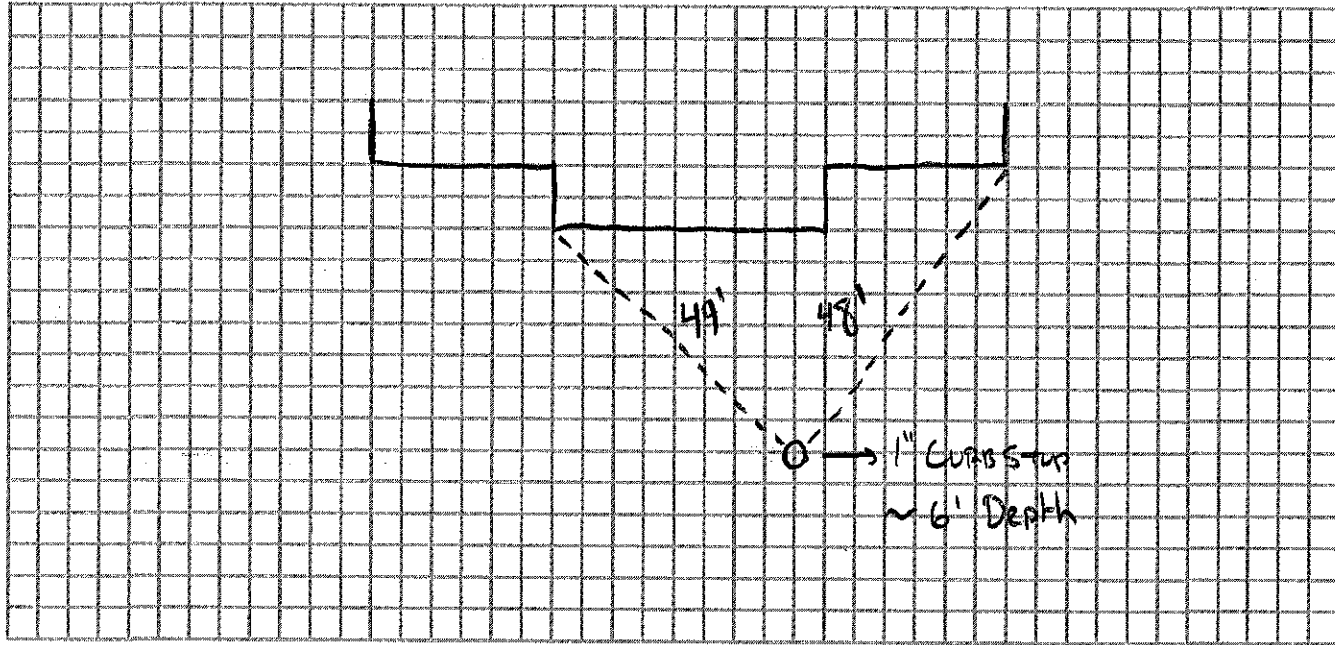

Connection made in: WOBURN ST

Street.

Work completed:

Remarks: INSTALLED BY BOULEY EXCAVATION