


Date: _____

TOWN OF LEXINGTON - BOARD OF PUBLIC WORKS
WATER DIVISION

SKETCH OF SERVICE HERE

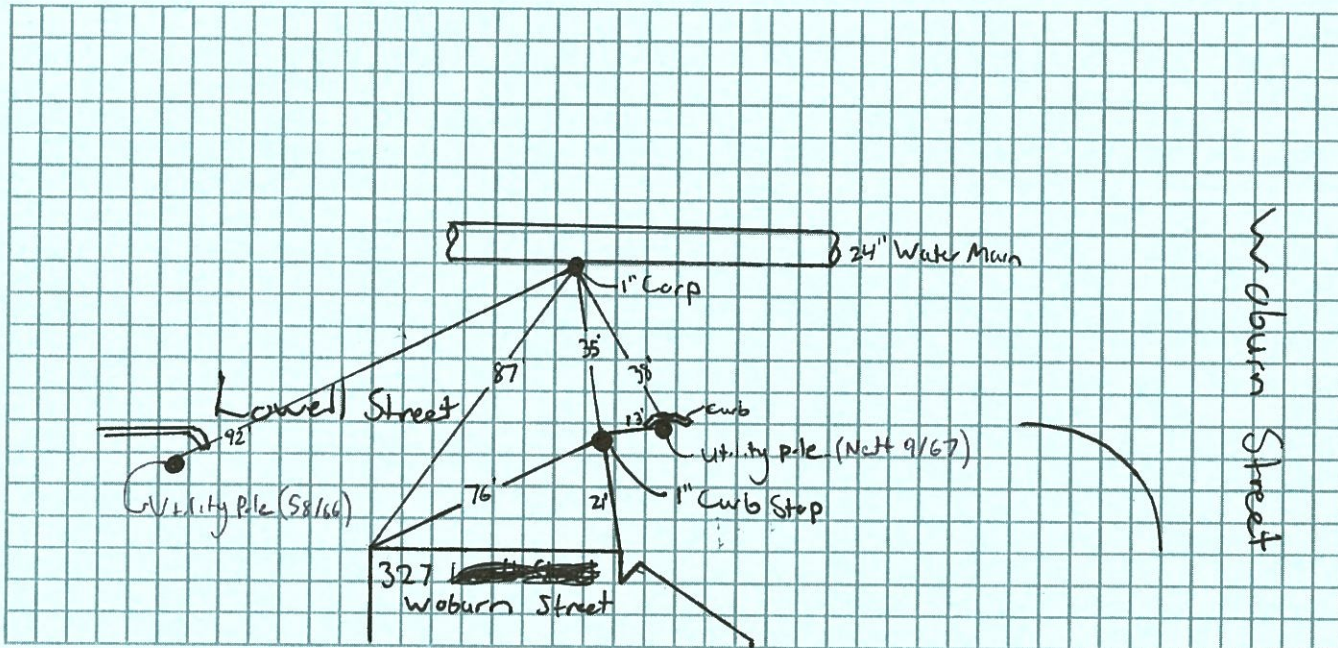

Connection made in: Lowell Street

Street.

Work completed:

Remarks:
.....
.....
