

WATER SERVICE RECORD

Name Frankini & Son, Inc.

Service No. 30

Address 330 Woburn St. (gas station)

Location Lexington


~~REPLACEMENT~~ New Service Com. 3/30/53

Date	Material	Amount	Total	Date	Amount
2/25/53	Labor	3 60		2-24-53 Deposited	70 -
	10% overhead	36	3 96	3-30-53 Refunded	(28 07)
	75' - 3/4" copper tubing @ .34		25 50		<u>NON CHARGE</u>
	1 -3/4" C x 1/2 I.W.H. stop & waste		4 00	2/25/53 Labor	18 64
	1 -3/4" C 3/4" C. union		1 72	18' - 3/4" copper tubing @ .34	6 12
	1 hr. trucking		75	1 -3/4" C. corp-cock	4 33
	patching 6 x 3		6 00	1 -3/4" C x 3/4" C. curb-cock	4 67
			41 93	1 box and rod	3 90
	TRENCH DUG BY OWNER			1 -1/2 straight tail piece	50
				1 -1/2 offset tail piece	50
				4 hrs. Littlefield shovel @ 7.	28 00
				1 hr. trucking	75
					<u>67 41</u>

TOWN OF LEXINGTON — BOARD OF PUBLIC WORKS

WATER DIVISION

Sketch of Service Here

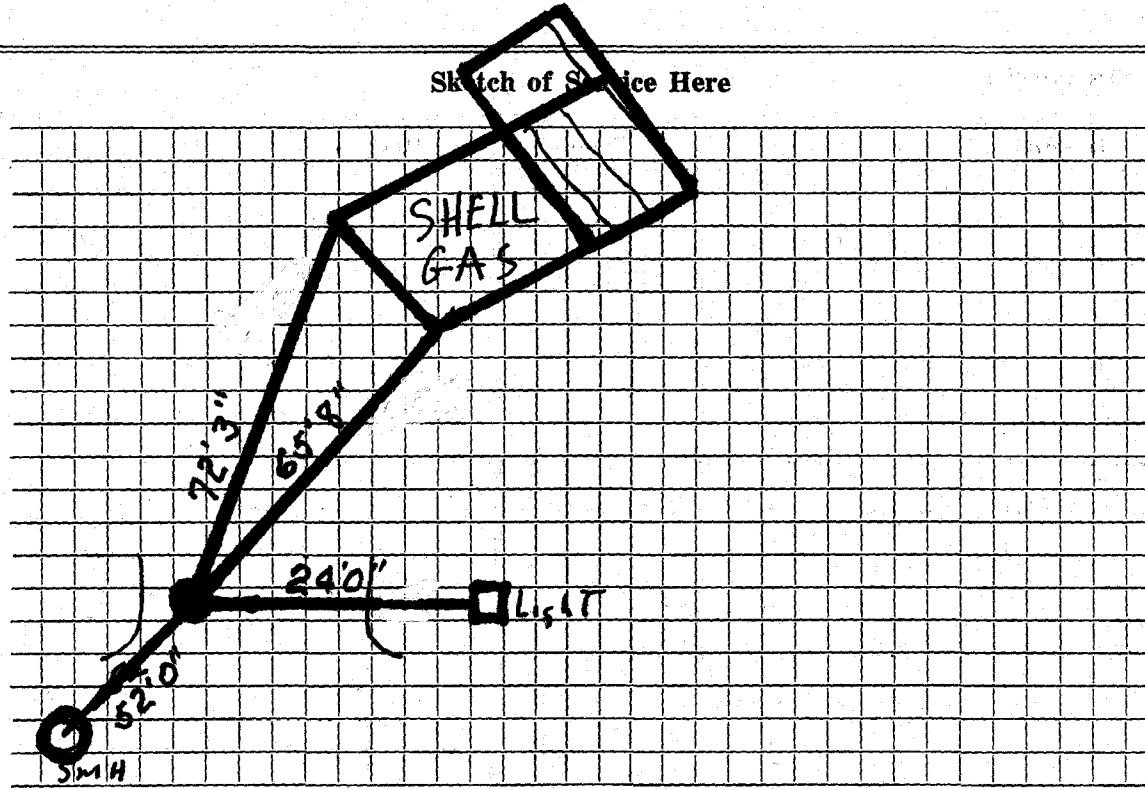

Connection made in Street. Work completed

Remarks:
.....
.....