

WATER SERVICE RECORD

Name Thomas Forde

Service No. 194

Address 333-335 WOBURN ST.

Location

Repair—Renewal—New Service


Comm 12-15-58

Date	Material	Amount	Total	Date	Amount
9/23/58	Labor	18 28		9-16-58	Deposit 75 00
	10% overhead	1 83	20 11	12-15-58	Retaind 18 27
	26' - 1" Copper tubing @ .5202		13 53		56 73
	1 - 1" Cx1" I.W.H. Stop & Waste		6 59		NON CHARGE
	1 hr. Trucking		3 00	Labor	7 36
	1 hr. Trucking		75	10' - 1" Copper tubing @ .5202	5 20
	1 hr. Rodgers Trailer		3 00	1 - 1" C. Corp Cock	7 06
	1 1/2 hrs. Town Shovel @ 6.50		9 75	1 - 1" C. Curb Cock	7 64
			56 73	1 Box & Rodd	5 00
				1 - 1" Straight tailpiece	50
				1 - 1" Offset tailpiece	50
				1/2 hr. Town Shovel @ 6.50	3 25
				1 hr. Trucking	75
					37 26

DATE _____

TOWN OF LEXINGTON — BOARD OF PUBLIC WORKS
WATER DIVISION

Sketch of Service Here

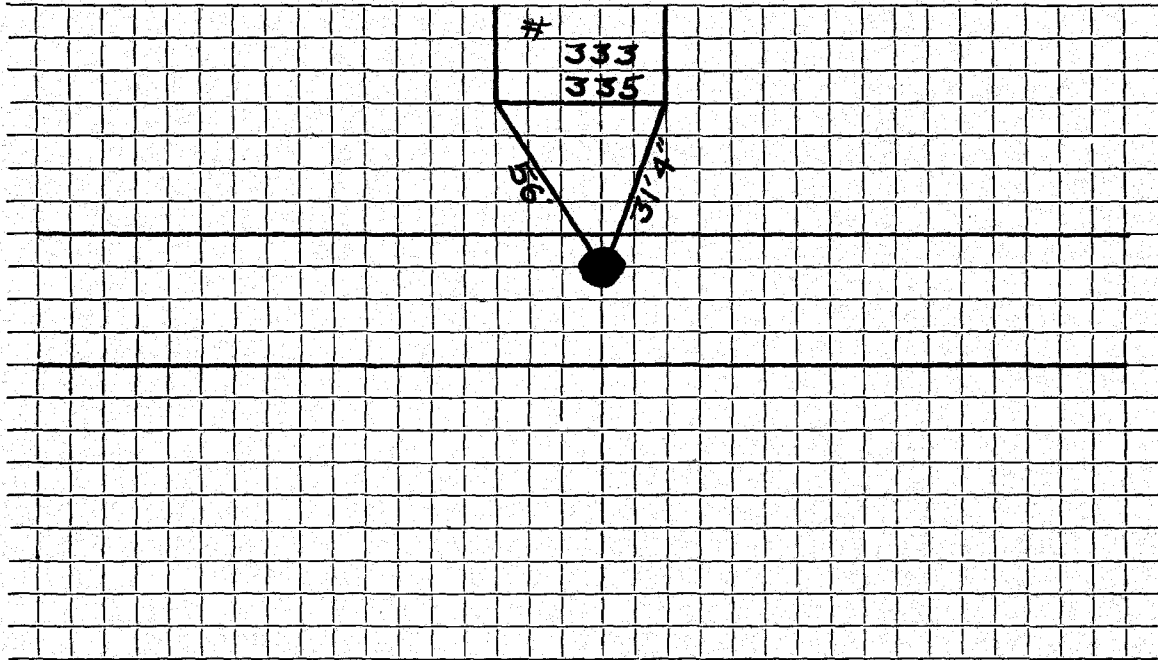

Connection made in Street. Work completed

Remarks:
.....
.....