

WATER SERVICE RECORD

Name Christopher Cammerata

Service No. 88

Address 334 Woburn Street

Location

~~WATER SERVICE~~ New Service


Date	Material	Amount	Total	Date	Material	Amount
10-23-64	Labor	4.84				
	10% O.H.	.48	5.32			
	56' 1" Copper tubing @.56		31.36			
	1 1" Comp. Valve		6.96			
	38 x 3 Patch		38.00	10-23-64	Labor	78.07
	1 hr. Trucking @3.00		3.00		38' 1" Copper tubing @.56	21.28
			84.64		1 1" C Corp Cock	7.31
					1 1" C Curb Cock	8.06
					1 Box & Rod	4.90
					1 hr. Trucking @3.00	3.00
					2 hrs. Town Shovel @6.50	13.00
					1 hr. Loader @3.00	3.00
						138.62

DATE: _____

TOWN OF LEXINGTON — BOARD OF PUBLIC WORKS

WATER DIVISION

Sketch of Service Here

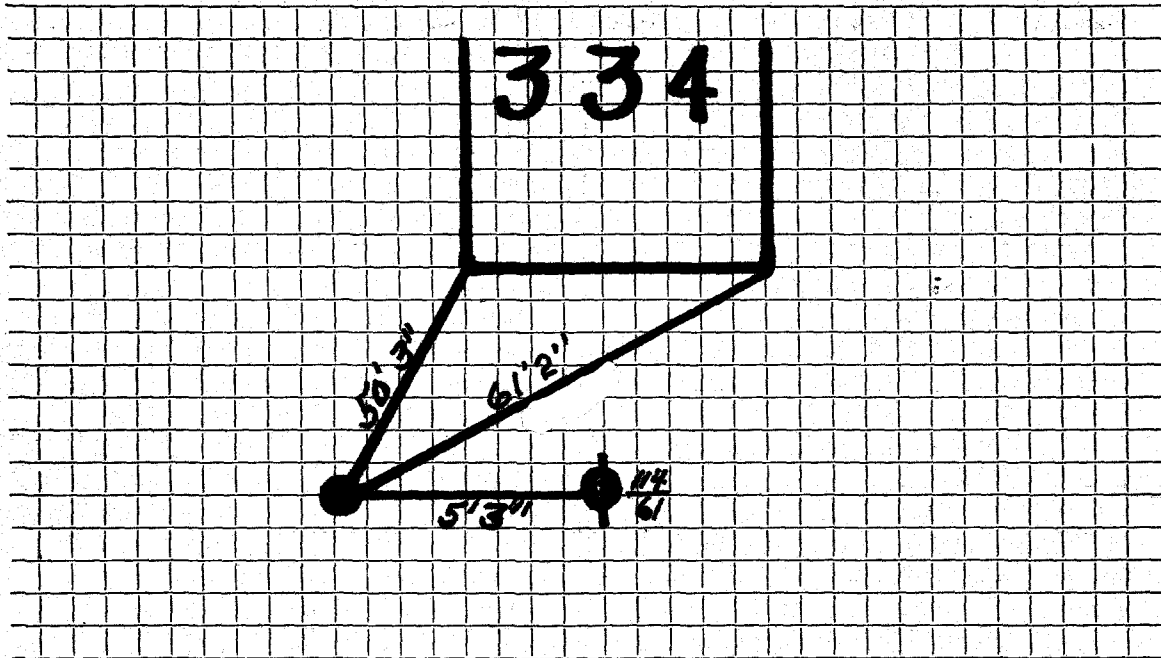

Connection made in Street. Work completed

Remarks:

.....

.....