


Water Service Tie Card
TOWN OF LEXINGTON
 MASSACHUSETTS

34 Woburn St

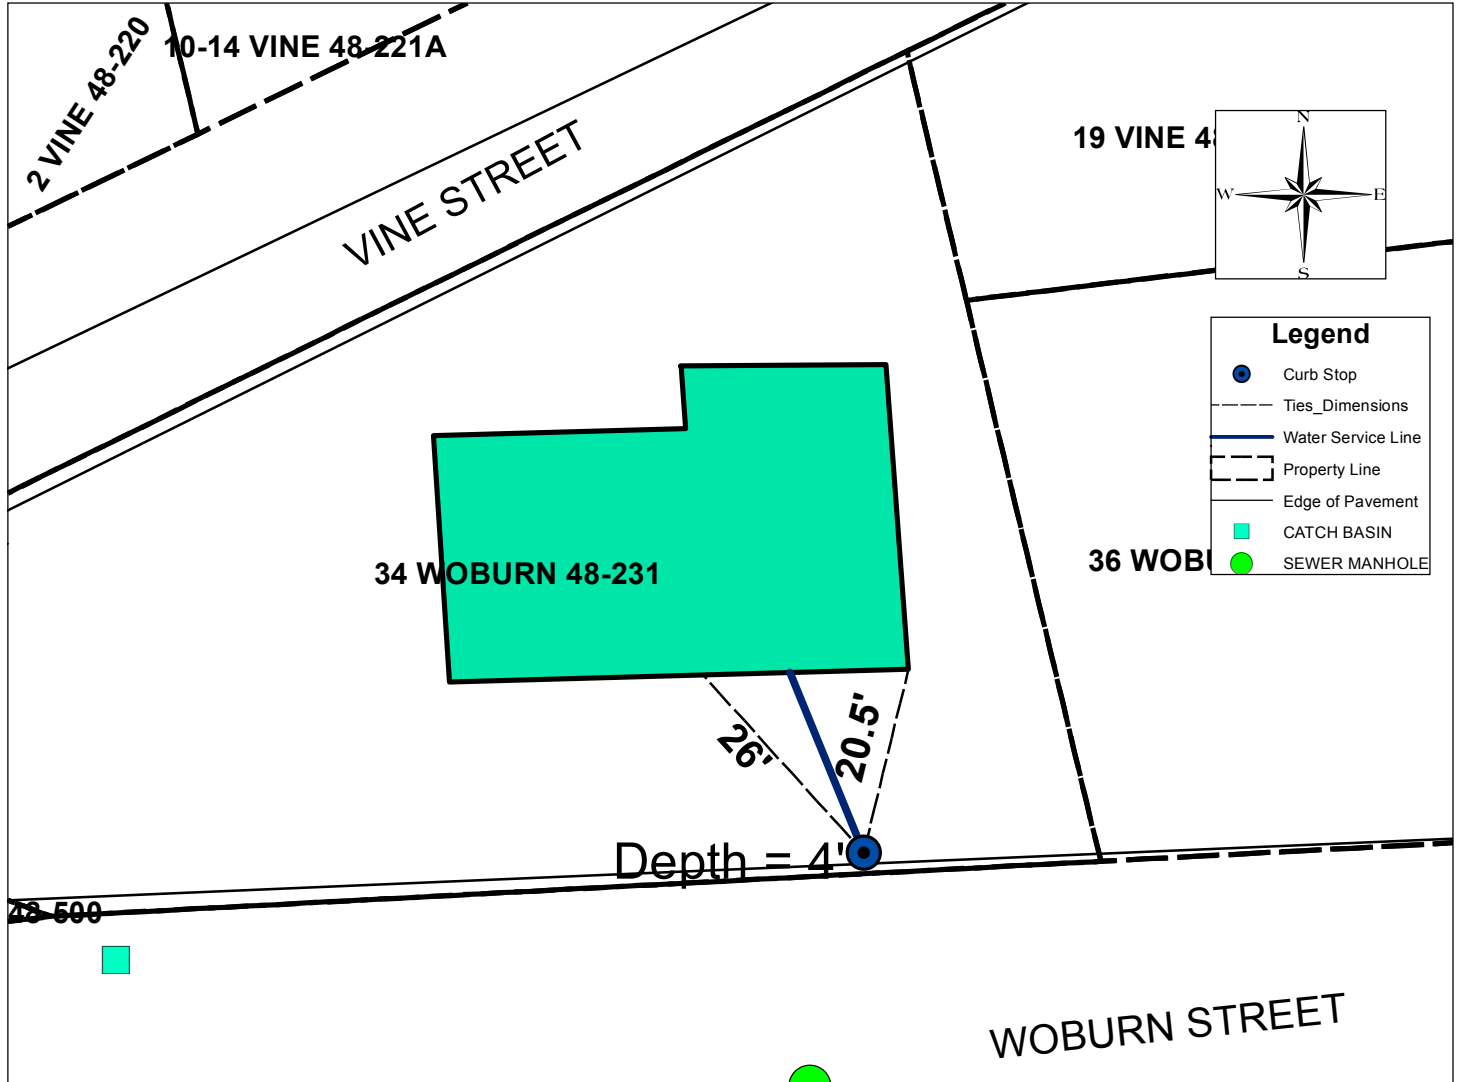

Address	Map and Lot	Permit Number	Contractor Name	Inspector
34 Woburn St.	48-231	6001	Eycon Construction	msprague
Date	Material	Depth of Cover	Amount	
12/22/2014	1" Copper type "k"	4 ft	6"	
	1" Curb Valve and Buffalo Box		1	
	1" Copper type "k"		20.5 ft	
	*Curb is on backwards.			
Type of work completed				
New 1" water service to house from curb stop. New house on lot old house removed.				