

WATER SERVICE RECORD

Name Kelley Corp.

Service No.

Address 352 Woburn St.

Location Lexington, Mass.


~~Repair/Extension~~ - New Service

| Date    |     | Material              | Amount | Total | Date    | Amount                                |
|---------|-----|-----------------------|--------|-------|---------|---------------------------------------|
|         |     |                       |        |       |         |                                       |
|         |     | <i>Non Charge</i>     |        |       |         | <i>No Charge</i>                      |
| 8-16-55 |     | patching 25 x 3       |        | 25 00 | 8/24/51 | Labor 11 15                           |
|         | 35' | 3/4" Copper           |        |       |         | 40' - 3/4" copper tubing @ .326 13 04 |
|         | 1   | 3/4" C. X 1/2" l.w.h. |        |       |         | 1 - 3/4" C. corp-cock 4 33            |
|         |     | STOP + Waste          |        |       |         | 1 - 3/4" C x 3/4" C. curb-cock 4 67   |
|         |     |                       |        |       |         | 1 - box and rod 4 68                  |
|         |     |                       |        |       |         | 2 hrs. littlefield shovel 14 00       |
|         |     |                       |        |       |         | 1 hr. trucking 75                     |
|         |     |                       |        |       |         | 52 62                                 |

DATE \_\_\_\_\_

TOWN OF LEXINGTON — BOARD OF PUBLIC WORKS  
WATER DIVISION

Sketch of Service Here

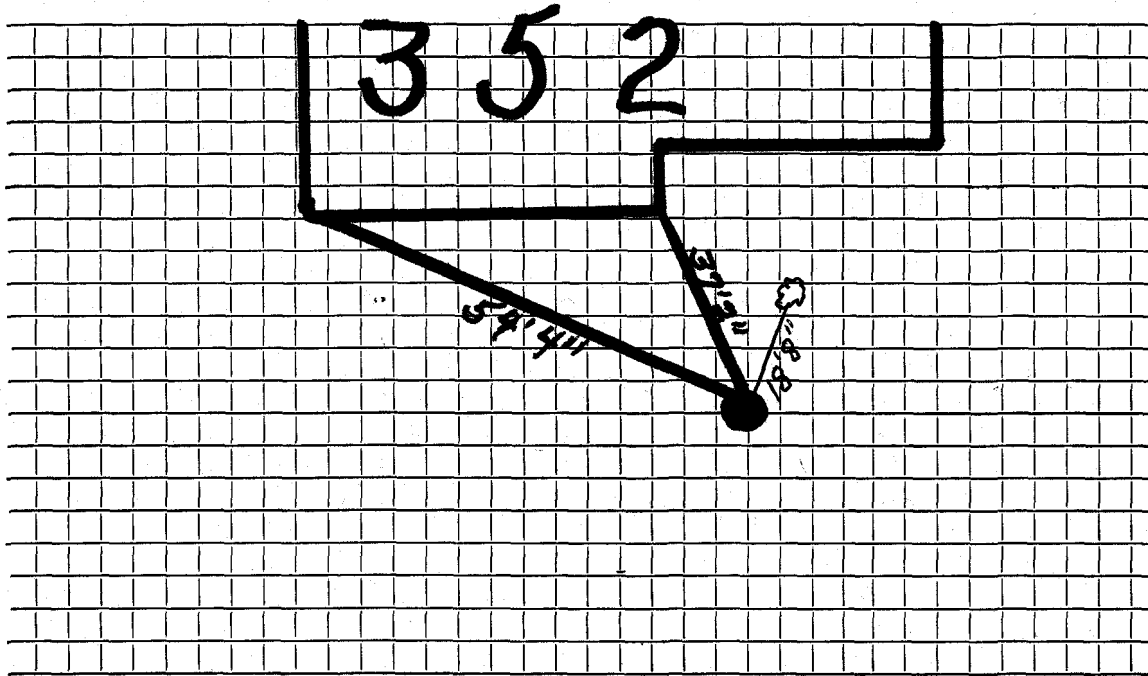

Connection made in ..... Street. Work completed .....

Remarks: .....

.....  
.....