

WATER SERVICE RECORD

566

Name Kelley Corp.

Service No. 166

Address 353 Woburn Street

Location Lexington, Mass.


~~Repair & Renewal~~ - New Service

Date	Material	Amount	Total	Date	Amount
7/27/51	Labor	1 49	1 49	7-19-51	Deposited 10 00
	10% overhead		15	10-11-51	paid 3 87
	20' -3/4" copper tubing @.326	6 52	6 52	4-29-52	paid 76
	1 -3/4" Cx $\frac{1}{2}$ I.W.H. stop&waste	4 00	4 00		<u>No Charge</u> 14 43
	1 -3/4"Cx3/4" C.union (3pts.)	1 72	1 72	7/27/51	Labor 3 00
	1 hr. trucking		75		10' -3/4" copper tubing @ .326 3 26
			14 63		1 -3/4" C. corp-cock 4 33
	Pipe supplied and laid by owner				1 -3/4" Cx3/4" C.curb- 4 67
					1 box and rod 4 68
					1 - $\frac{1}{2}$ offset tail piece 50
					1 - $\frac{1}{2}$ straight tail piece 50
					2 hrs. Littlefield shovel 14 00
					1 hr. trucking 75
					35 69
					bill sent 10-1-51

DATE \_\_\_\_\_

TOWN OF LEXINGTON — BOARD OF PUBLIC WORKS  
WATER DIVISION

Sketch of Service Here

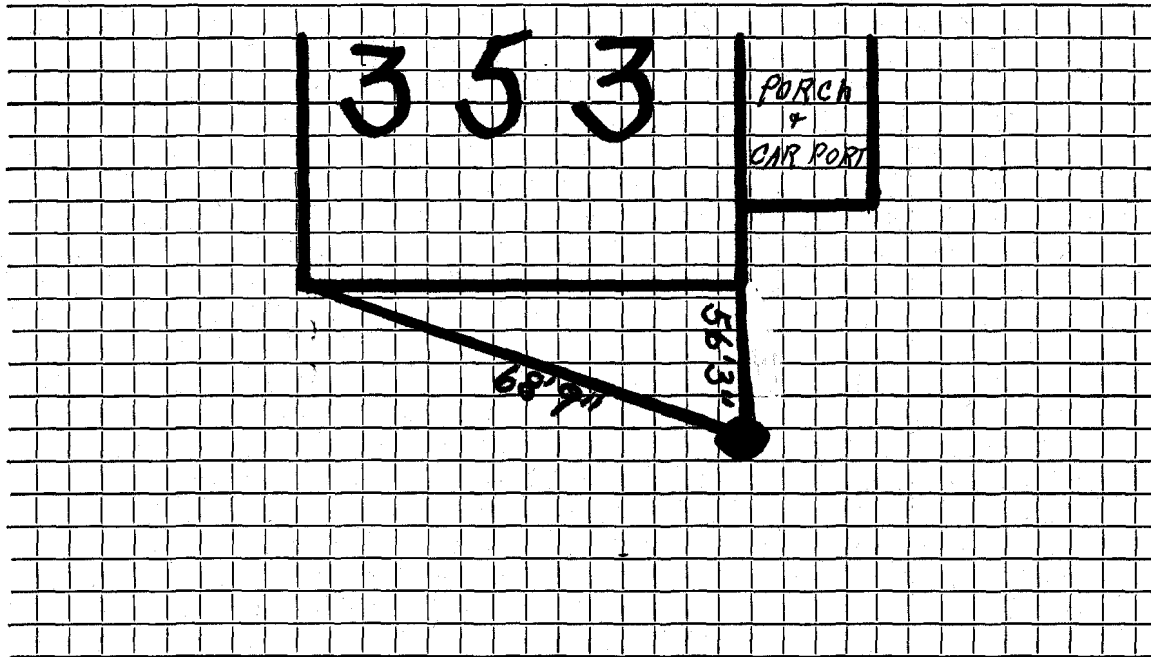

Connection made in ..... Street. Work completed .....

Remarks: .....

.....

.....