

WATER SERVICE RECORD

Name Kelley Corp.

Service No. _____

Address 358 Woburn St.

Location Lexington, Mass.


Repair Renewal New Service

Date	Material	Amount	Total	Date	Amount
9-28-55	55' 3/4" Copper				
	1 3/4" C. X 1/2" I.W.H. Stop-Waste				
	including 25' x 1/2"		25 00	8/24/51	
					<u>No Charge</u>
					Labor 11 15
					40' - 3/4" copper tubing @ .326 13 04
					1 - 3/4" C. corp-cock 4 33
					1 - 3/4" C x 3/4" C. curb-cock 4 67
					1 - box and rod 4 68
					2 hrs. Littlefield shovel @ 7. 14 00
					1 hr. trucking 75
					52 62

DATE _____

TOWN OF LEXINGTON — BOARD OF PUBLIC WORKS
WATER DIVISION

Sketch of Service Here

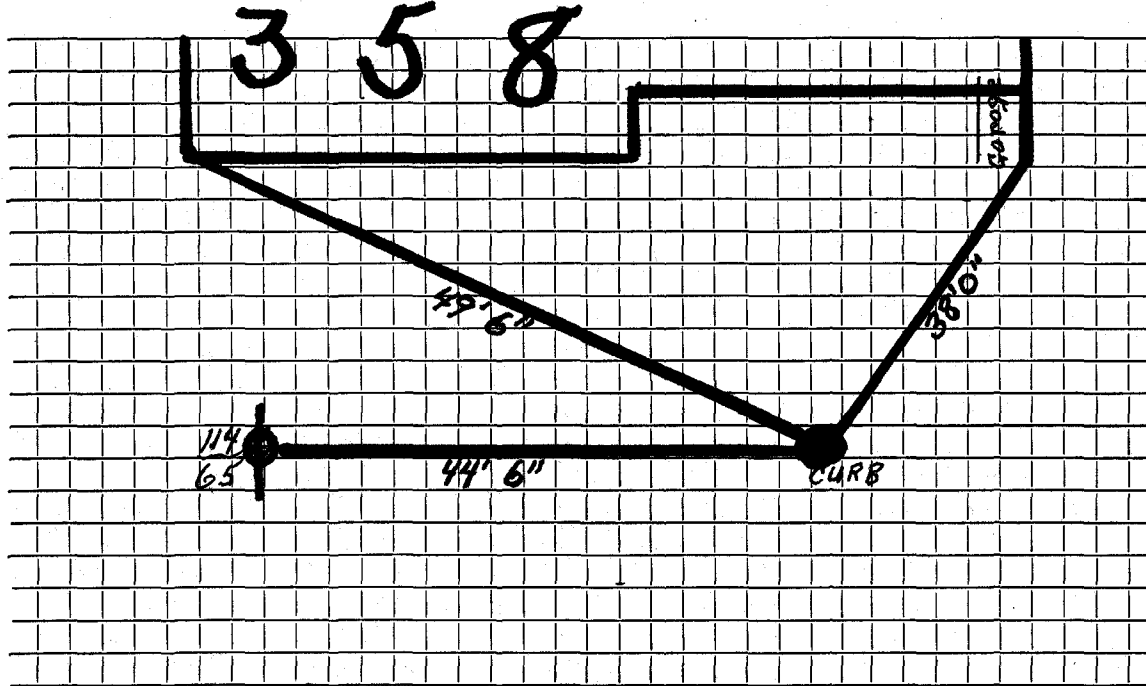

Connection made in Street. Work completed

Remarks:

.....

.....