


DATE _____

TOWN OF LEXINGTON — BOARD OF PUBLIC WORKS

WATER DIVISION

Sketch of Service Here

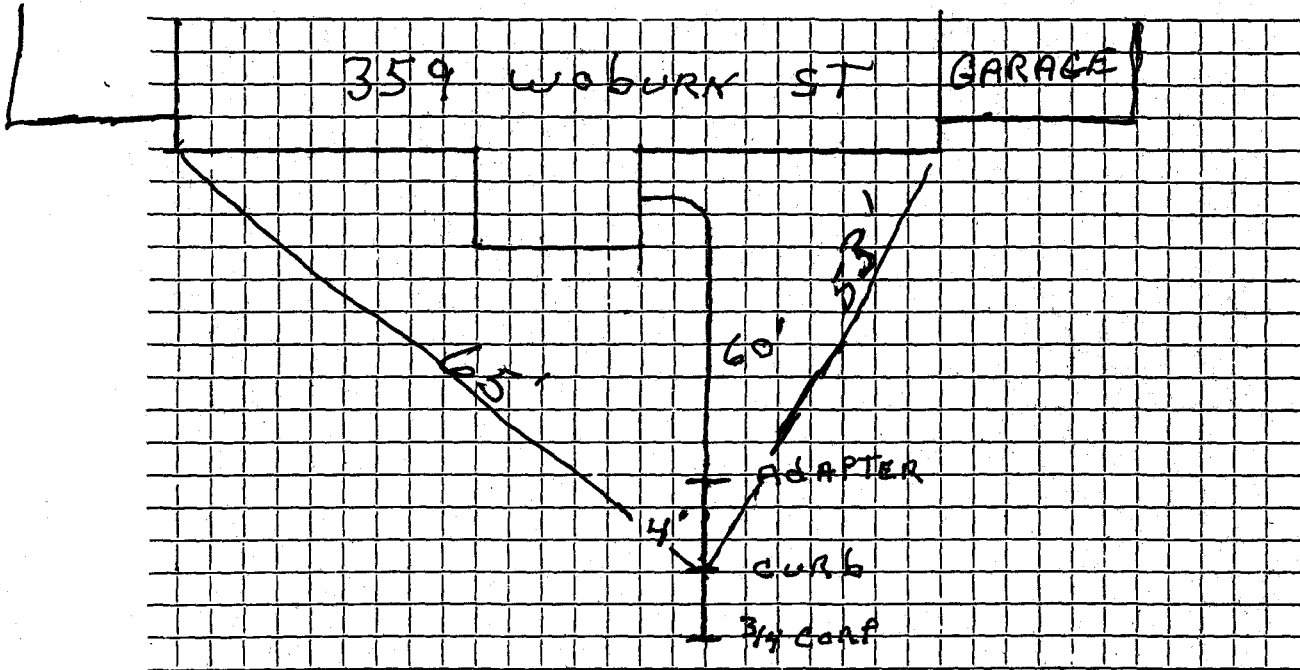

Connection made in ..woburn...st..... Street. Work completed

Remarks: INSTALLED BY WHIT BUILDERS.....