




DATE \_\_\_\_\_

TOWN OF LEXINGTON — BOARD OF PUBLIC WORKS

WATER DIVISION

Sketch of Service Here

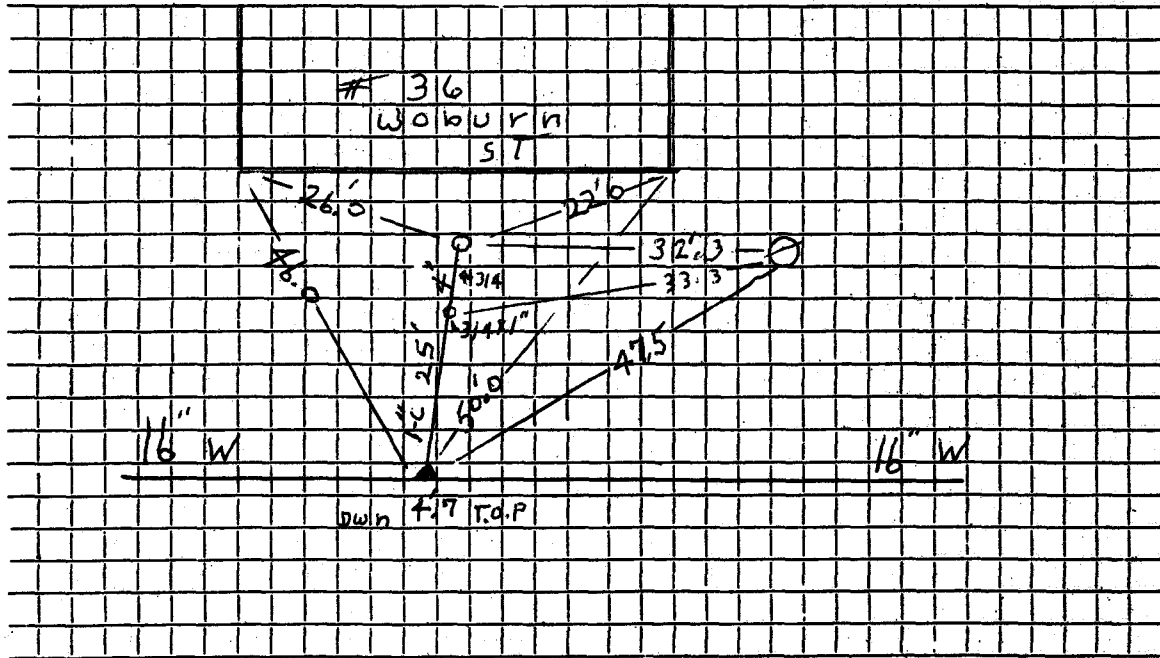

Connection made in ..... Street. Work completed Sept 14/07 .....

Remarks: Keep Exist. curb. Stop. due to dust, banks, Etc. .....

.....

.....