

WATER SERVICE RECORD

Name Kelley Corp.

Service No.

Address 364 Woburn St.

Location Lexington, Mass.


~~Repair~~ — New Service

Date	Material	Amount	Total	Date	Amount
11-55	40' 3/4" Copper				
	1 3/4" C. X 1/2" I.W.H. Stop + Waste				
	<del>material</del>		25 00		
				8/24/51	
					<u>No Charge</u>
				Labor	11 15
				40' - 3/4" copper tubing @ .326	13 04
				1 - 3/4" C. corp-cock	4 33
				1 - 3/4" C x 3/4" C. curb-cock	4 67
				1 - box and rod	4 68
				2 hrs. littlefield shovel	14 00
				1 hr. trucking	75
					<u>52 62</u>

DATE \_\_\_\_\_

TOWN OF LEXINGTON — BOARD OF PUBLIC WORKS  
WATER DIVISION

Sketch of Service Here

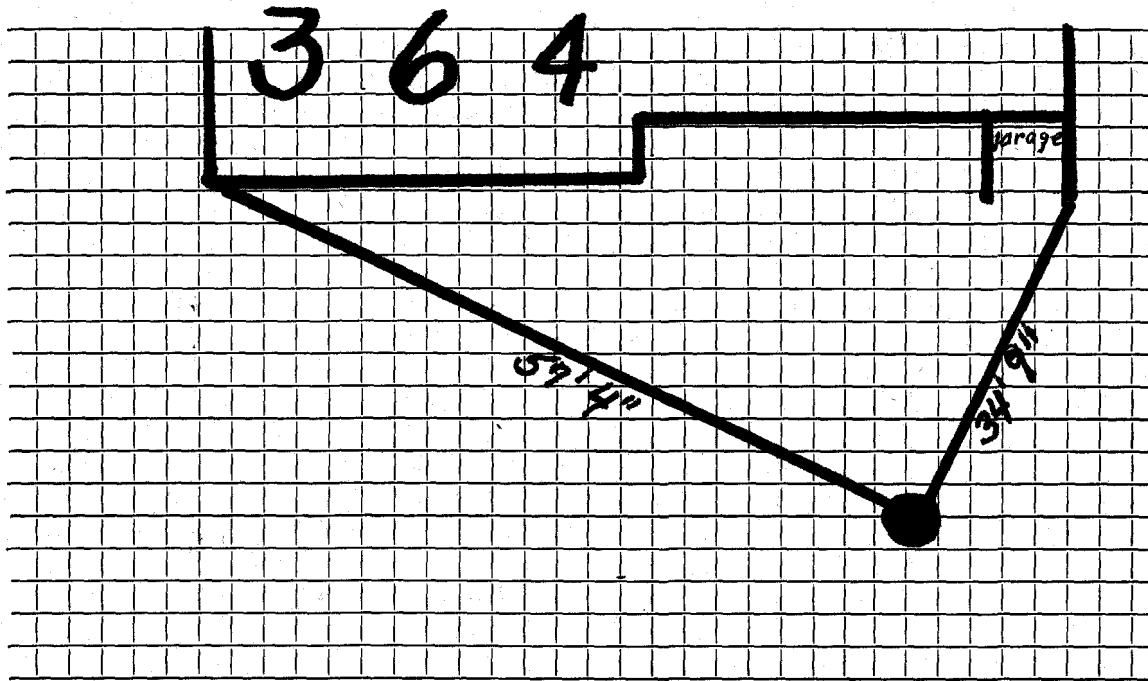

Connection made in ..... Street. Work completed .....

Remarks: .....  
.....  
.....