

R#8 1/2

WATER SERVICE RECORD

4880

Name Kelly Corp.

Service No. 61

Address 369 Woburn Street

Location Lexington

~~Repair or Renewal~~ - New Service

Cam. 6-16-52


Date	Material	Amount	Total	Date	Amount
5/13/52	Labor	1 63		4-21-52 Deposited	15 00
	10% overhead	16	1 79	6-16-52 <i>Refunded</i>	(8 46)
	1 - 3/4" Cx 1/2" I.W.H. stop & waste	4 00		NON CHARGE	6 54
	1 - hr. trucking		75	5/13/52 Labor	13 57
			6 54	5' - 3/4" copper tubing @ .3439	1 71
	TRENCH DUG BY OWNER			1 - 3/4" C. corp-cock	4 33
	PIPE SUPPLIED AND LAID BY OWNER			1 - 3/4" C x 3/4" C. curb-cock	4 67
				1 box and rod	4 52
				1 - 1/2" offset tail piece	50
				1 - 1/2" straight tail piece	50
				1 - hr. trucking	75
					30 55

DATE _____

TOWN OF LEXINGTON — BOARD OF PUBLIC WORKS

WATER DIVISION

Sketch of Service Here

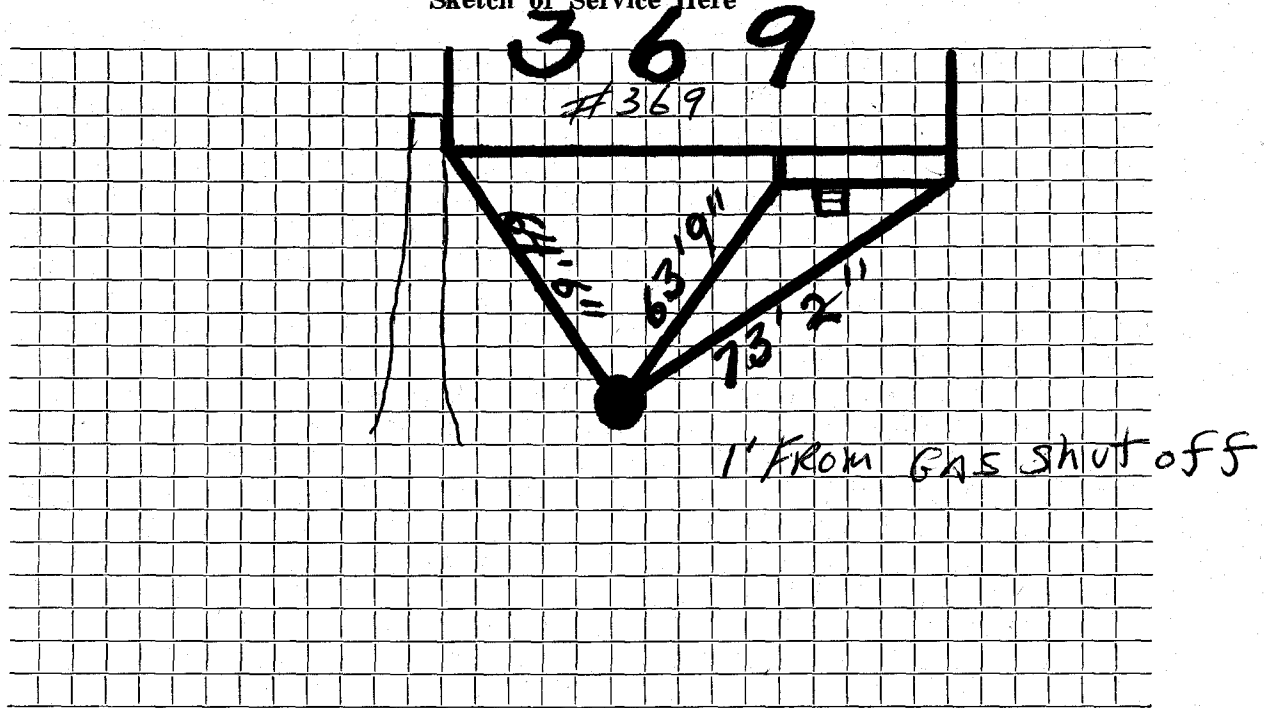

Connection made in Street. Work completed

Remarks:

.....
.....