

WATER SERVICE RECORD

3210

Name Kelley Corp.

Service No. 165

Address 374 Woburn Street

Location Lexington, Mass.


Repair ~~Remove~~ - New Service *Com 10/1/51*

Date	Material	Amount	Total	Date	Amount
7/31/51	Labor	1 49	1 49	7-19-51	Deposited 35 00
	10% overhead		15	10-1-51	Refunded & credited to W.H.C. #1219 12 61
	1 -3/4" Cx 1/2 I.W.H. Stop & Waste		4 00		No Charge 31 39
	1 hr. trucking		75	7/31/51	Labor 4 03
	patching 25 x 3		25 00	8/2/51	" 11 59
			31 39		40' -3/4" copper tubing @ .326 13 04
					1 -3/4" C. corp-cock 4 33
	Pipe supplied and laid by owner				1 -3/4" Cx 3/4" C. curb-cock 4 67
					1 box and rod 4 68
					1 -1/2 offset tail piece 50
					1 - 1/2 straight tail piece 50
					4 hrs. - Littlefield shovel @ 7.00 28 00
					1 hr. trucking 75
					72 09

DATE \_\_\_\_\_

TOWN OF LEXINGTON — BOARD OF PUBLIC WORKS  
WATER DIVISION

Sketch of Service Here

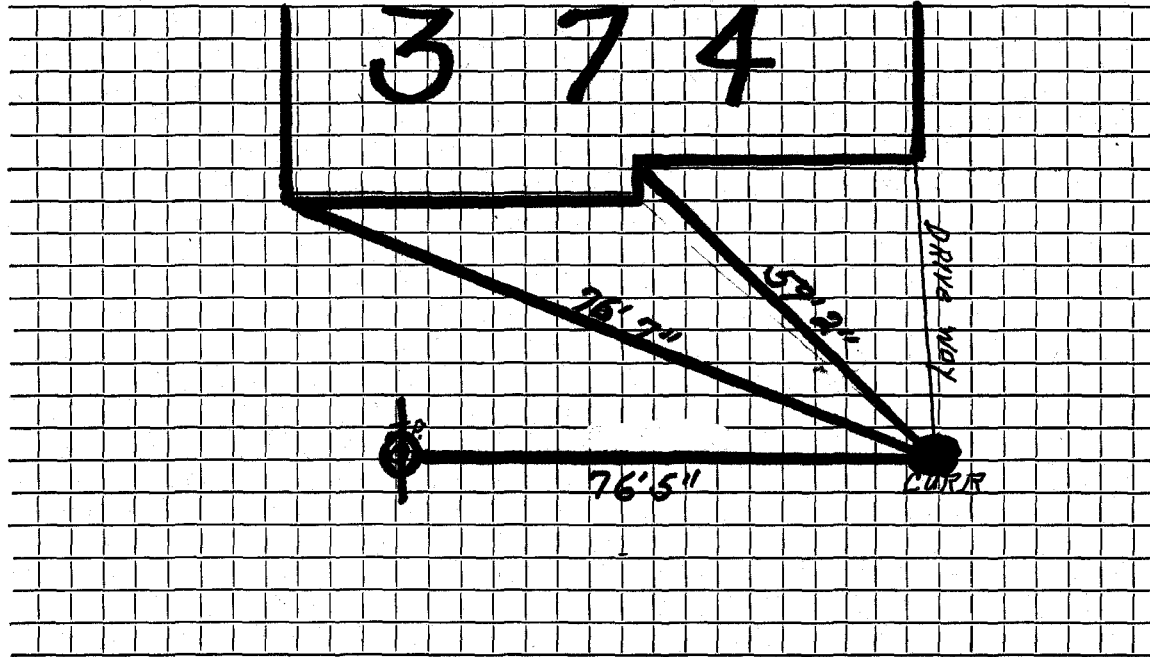

Connection made in ..... Street. Work completed .....

Remarks: .....

.....

.....