




DATE 11/19/20

TOWN OF LEXINGTON — BOARD OF PUBLIC WORKS

WATER DIVISION

Sketch of Service Here

# 378

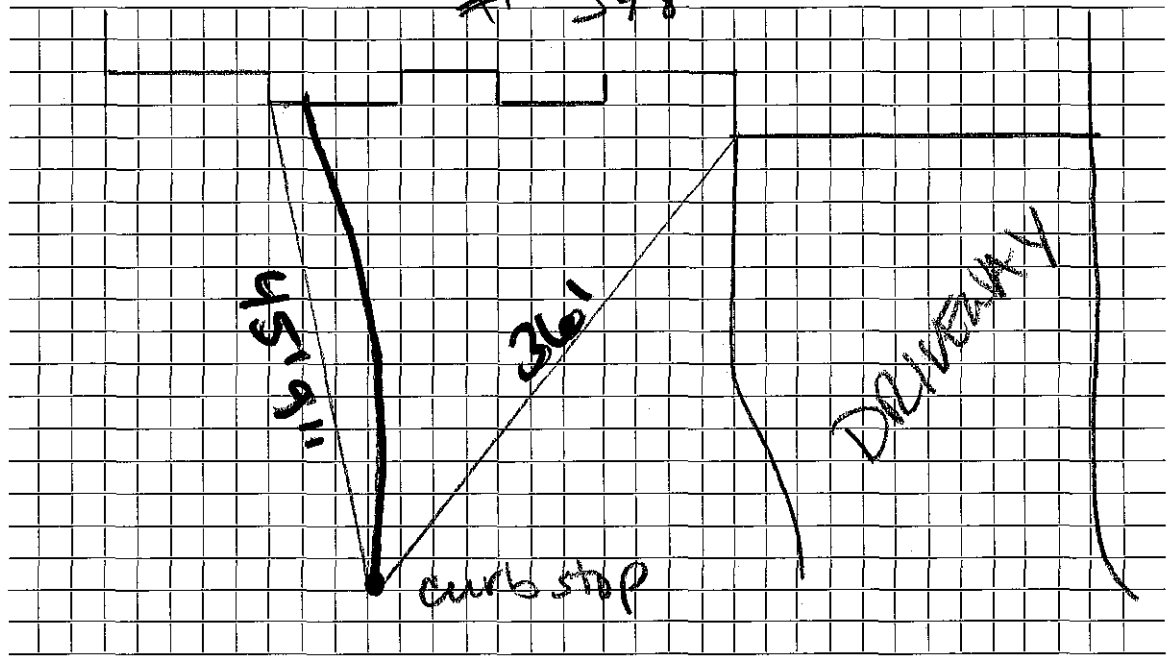

Connection made in..... Woburn ..... Street. Work completed .....

Remarks:.....  
.....  
.....