


DATE 5-5-01

TOWN OF LEXINGTON — BOARD OF PUBLIC WORKS
WATER DIVISION

Sketch of Service Here

384 Woburn St

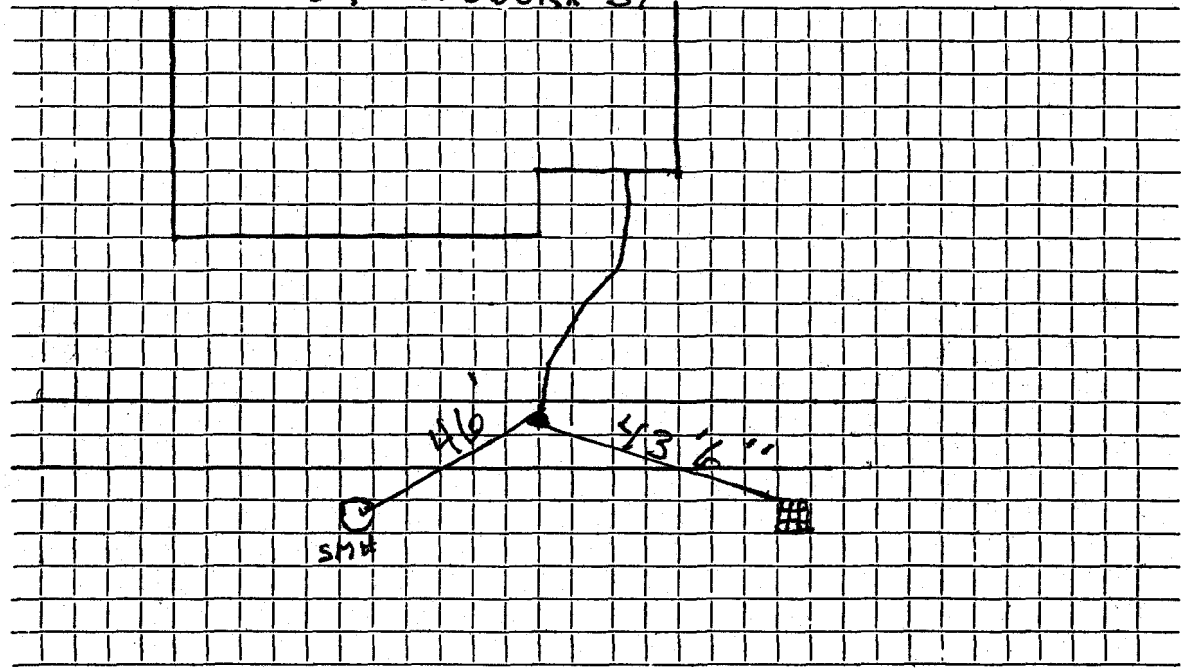

Connection made in Woburn St Street. Work completed 5-5-01
Remarks: INSTALLED BY EMPIRE CONSTRUCTION