

R \$846

WATER SERVICE RECORD

#4713

Name Kelly Corp.

Service No. 61

Address 389 Woburn St.

Location Lexington

~~Repair~~ Renewal - New Service

Com. 6-16-52


Date	Material	Amount	Total	Date	Amount
5/14/52	Labor	1 63		4-21-52 Deposited	15 00
	10% overhead	16	1 79	6-16-52 Refunded	CP 46
	1 - 3/4" Cx 1/2 I.W.H. stop&waste	4 00		NON CHARGE	6 54
	1 hr. trucking		75	5/14/52 Labor	5 62
			6 54	5' - 3/4" copper tubing @ .3439	1 72
	TRENCH DUG BY OWNER			1 - 3/4" C. corp-cock	4 33
	PIPE SUPPLIED AND LAID BY OWNER			1 - 3/4" C x 3/4" C. curb-cock	4 67
				1 - box and rod	4 52
				1 - 1/2 offset tail piece	50
				1 - 1/2 straight tail piece	50
				1 hr. Littlefield shovel	7 00
				1 hr. trucking	75
					<u>29 61</u>

DATE _____

TOWN OF LEXINGTON — BOARD OF PUBLIC WORKS

WATER DIVISION

Sketch of Service Here

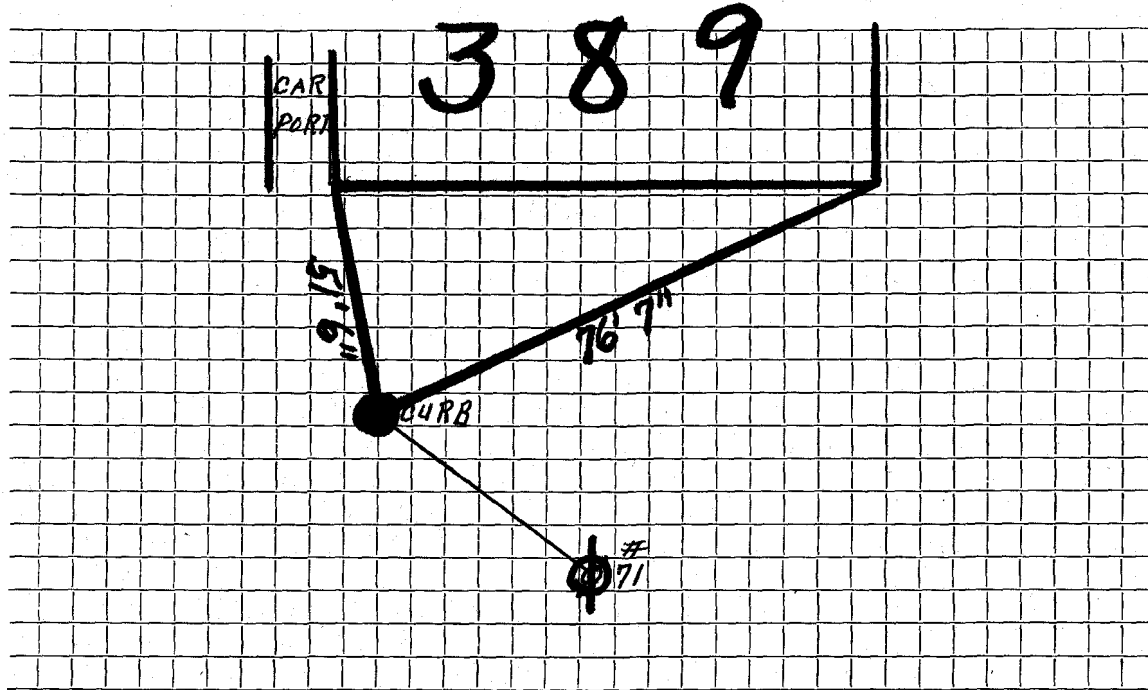

Connection made in Street. Work completed

Remarks:
.....
.....