

WATER SERVICE RECORD

#5259

Name Kelley Corp.

Service No.

Address 390 Woburn Street

Location Lexington, Mass.


~~Repair - Renewal~~ - New Service

Date	Material	Amount	Total	Date	Amount
5-14-52	60' 3/4" Copper				
	1 3/4" C. x 1/2" l.w.h. Stop + Waste				
	<del>patching 25 x 3</del>		<del>25 00</del>		
				8/25/51	
					<u>No Charge</u>
				Labor	10 99
				40' - 3/4" copper tubing @ .326	13 04
				1 - 3/4" C. corp-cock	4 33
				1 - 3/4" C x 3/4" C. curb-cock	4 67
				1 box and rod	4 68
				2 hrs. Littlefield shovel	14 00
				1 hr. trucking	75
					<u>52 46</u>

DATE \_\_\_\_\_

TOWN OF LEXINGTON — BOARD OF PUBLIC WORKS  
WATER DIVISION

Sketch of Service Here

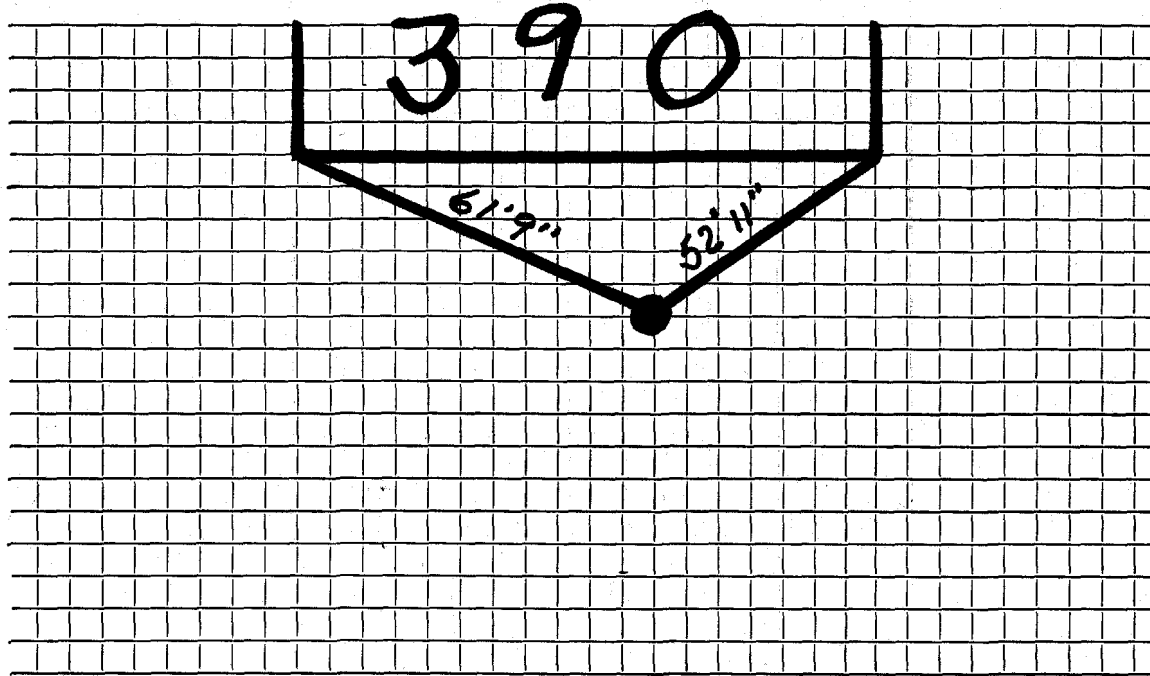

Connection made in ..... Street.                      Work completed .....

Remarks: .....  
.....  
.....