




DATE \_\_\_\_\_

TOWN OF LEXINGTON — BOARD OF PUBLIC WORKS

WATER DIVISION

Sketch of Service Here

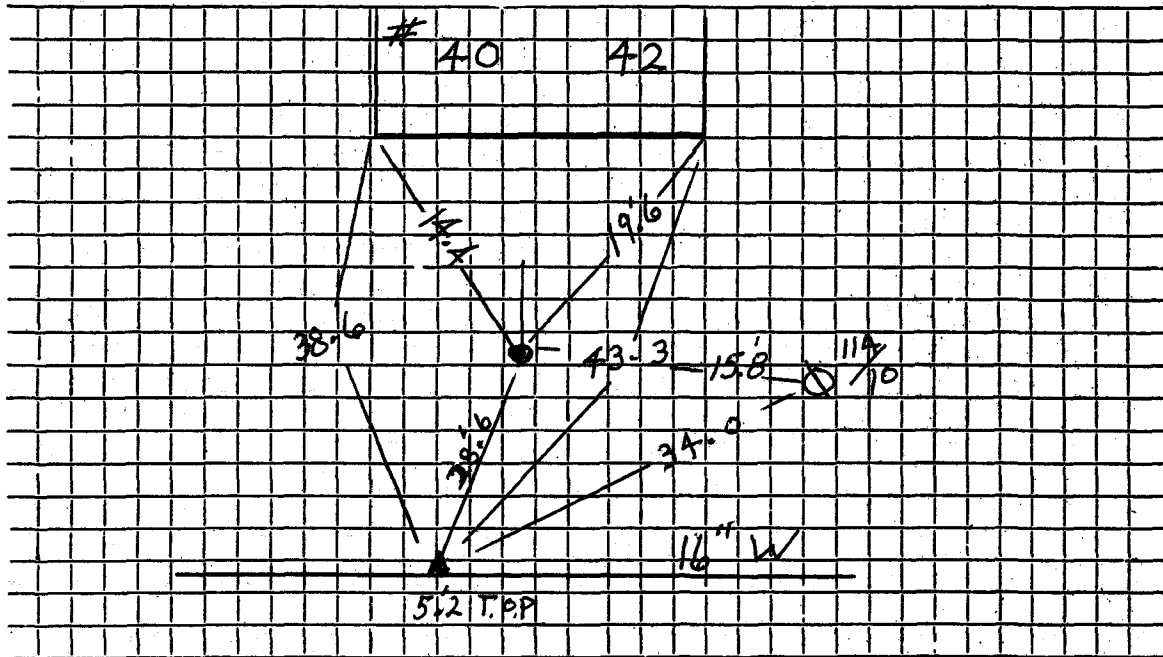

Connection made in ..... Street.

Work completed 9/14/07 Deflice .....

Remarks: 1: .....

.....

.....