


Date: 4/25/24

TOWN OF LEXINGTON - BOARD OF PUBLIC WORKS
WATER DIVISION

SKETCH OF SERVICE HERE
410 WOBURN ST.

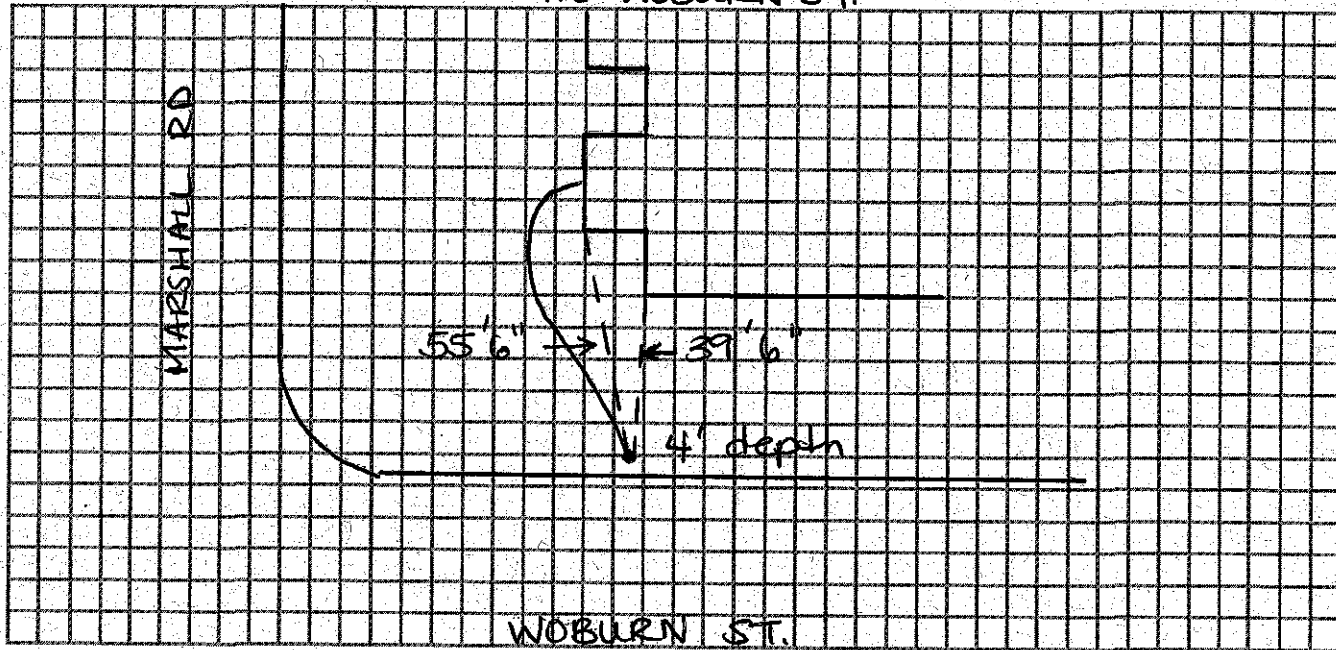

Connection made in:

Street.

Work completed:

Remarks: Installed by UTICON

