


DATE _____

TOWN OF LEXINGTON — BOARD OF PUBLIC WORKS

WATER DIVISION

Sketch of Service Here

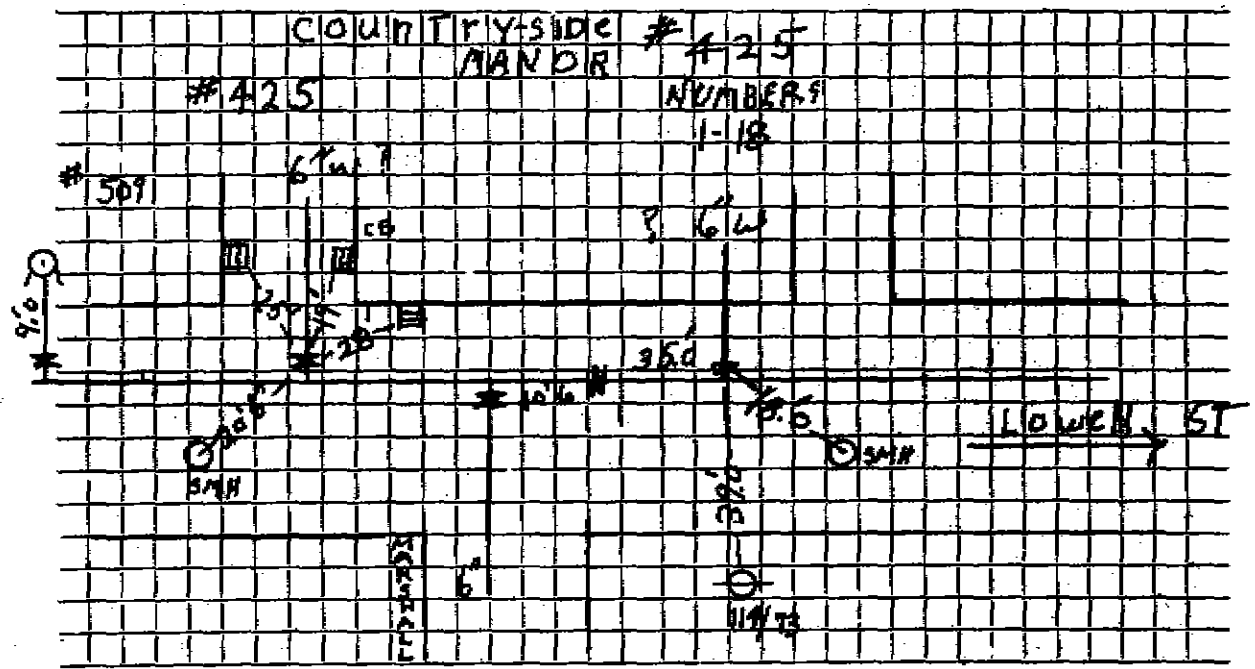

Connection made in Woburn St Street. Work completed Jim McLaughlin

Remarks: Tie No. 69-2