

WATER SERVICE RECORD

Name

Service No.

Address 43A 43-B Woburn ST

Location

LOT 273

Repair—Renewal—New Service


Date		Material	Amount	Total	Date	Deflice	Amount		
8/16/32	20'	3/4 Copper		43-A	SEP 07	32.5	1" Copper		
	1	3/4 S+W					1	1" Corp	
							1	1" Curb Stop	
							1	1 3/4 Red bufflo box	
				43-B				SEP. 07 left IN OFF POSITION for 43-B	
							32.5	1" Copper	
								1	1" Corp
								1	1" Curb Stop bufflo box

DATE _____

TOWN OF LEXINGTON — BOARD OF PUBLIC WORKS

WATER DIVISION

Sketch of Service Here

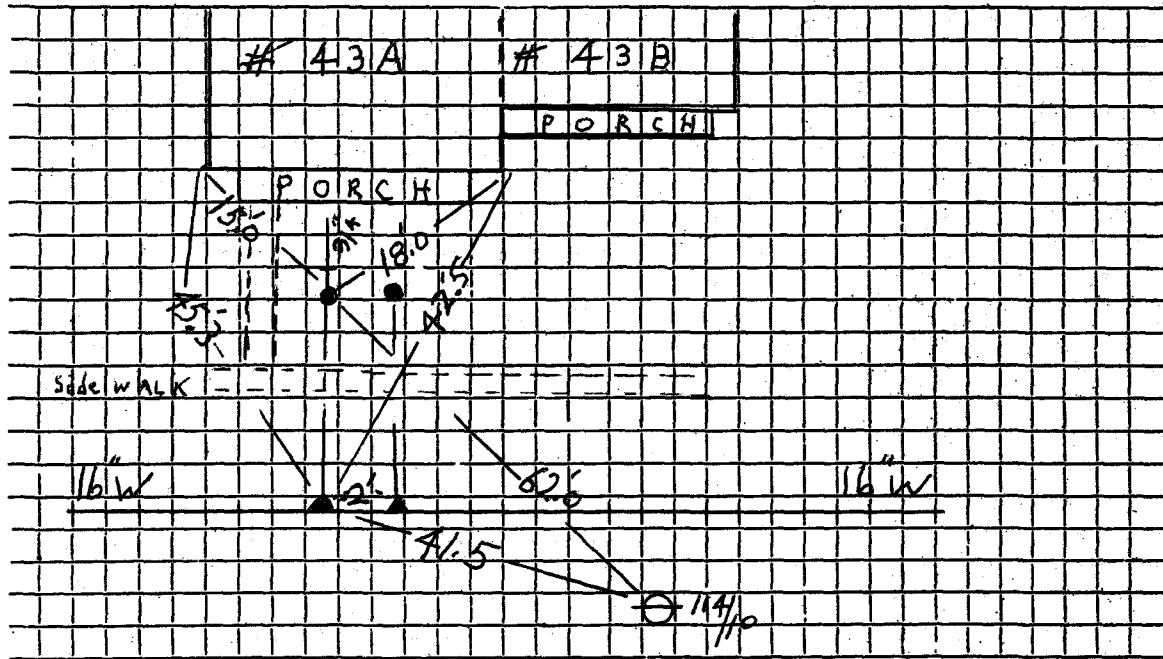

Connection made in Woburn St. 16" W.M. Street. Work completed Sept. 07. Def. l/c e.....

Remarks: Curb ST. P. for 43B left IN. OFF. POSITION. No Service To house.....