

WATER SERVICE RECORD

Name

Service No.

Address 44 Woburn ST

Location

LOT 235

Repair—Renewal—New Service


Date	Material	Amount	Total	Date	OUTSIDE ST.	Amount
9/1/94	McLAUGHLIN	750.00		2-22-94	8' 3/4" COPPER	
Town supplied	40' 3/4" COPPER	1.62 FT			3/4" COMP. CORPORATION	
	1 3/4" UNION	5.80			3/4" COMP CURB	
					BOX & ROD	
					<del>4" 3/4" COPPER TO 1/2" ROD</del>	

DATE \_\_\_\_\_

TOWN OF LEXINGTON — BOARD OF PUBLIC WORKS

WATER DIVISION

Sketch of Service Here

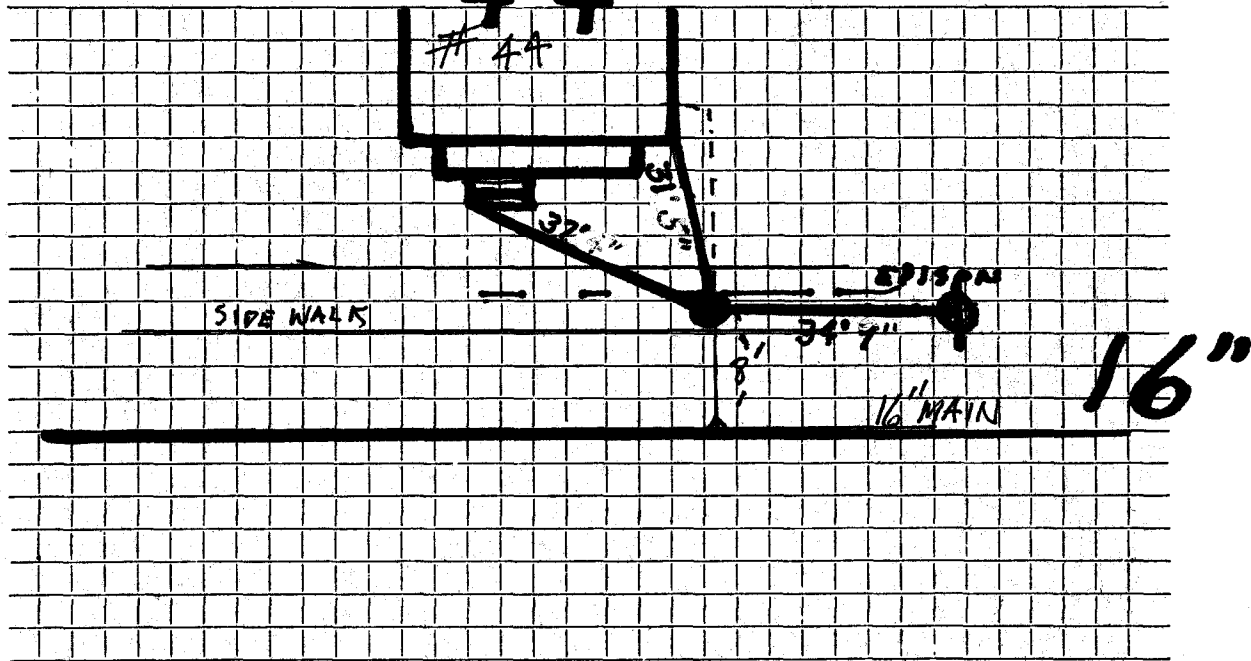

Connection made in WOBURN ST Street. Work completed 2-22-94

Remarks: TAP 3/4" ON 16" MAIN - 3/4 COMPUNION 8" BEYOND CURB UNDER EP. DUCT