

**WATER SERVICE RECORD**

Name

Service No.

Address **48 Woburn ST**

Location

Repair—Renewal—New Service


**LOT 236**

Date	Material	Amount	Total	Date	Amount
12/7/1940	32' 3/4" COPPER			1940	3/4" Curb Stob
	1 3/4 C.S+W				130x+ Rod
				7/6/90	3/4" COPP
					8' - 3/4 COPPER TAP-1/6" MAIN

TOWN OF LEXINGTON — BOARD OF PUBLIC WORKS

WATER DIVISION

Sketch of Service Here

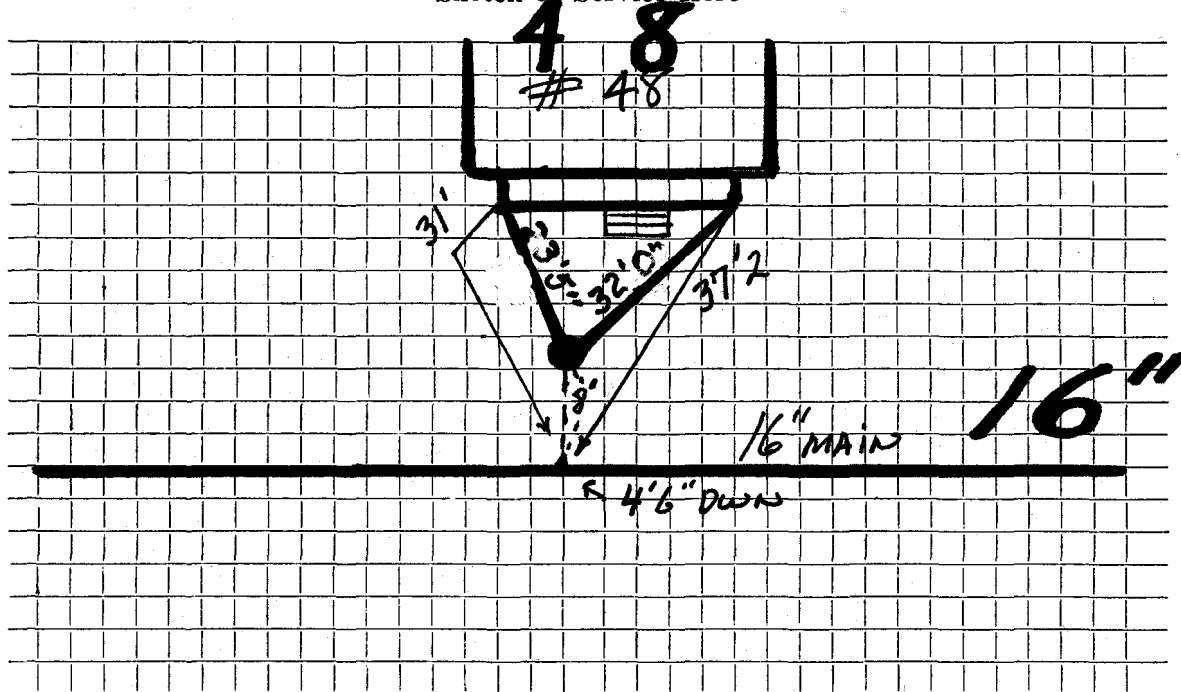

Connection made in Woburn ST Street. Work completed .....

Remarks: KILLED AT 10" MAIN TAP ON 16" MAIN .....