

WATER SERVICE RECORD

Name Mahoney & DeVincent Builders

Service No. 52

Address 480 Woburn Street

696

Location

~~Repair~~ ~~Renewal~~ New Service


Comm 6-19-61

| Date | Material | Amount | Total | Date | Amount |
|--------|----------------------------------|--------|--------|---------|-------------------------------|
| 5-1-61 | Labor | 27.72 | | 4-26-61 | Deposit 100.00 |
| | 10% O.H. | 2.77 | 30.49 | 9-28-61 | Paid 5.61 |
| 60' | 3/4" Copper Tubing @.42 | | 25.20 | | NON CHARGE 105.61 |
| 1 | 3/4" C x 1/2 I.W.H. Stop & Waste | | 6.17 | 5-1-61 | Labor 12.94 |
| 1 1/2 | Hr. Town Shovel @6.50 | | 9.75 | 28' | 3/4" Copper Tubing @.42 11.76 |
| 2 | Hrs. Trucking @3.00 | | 6.00 | 1 | 3/4" C Corp Cock 4.91 |
| 28 | x 3 Patch | | 28.00 | 1 | 3/4" C Cubb Cock 6.28 |
| | | | 105.61 | 1 | Box & Rod 4.90 |
| | | | | 1 | 1/2 Straighttailpiece .50 |
| | | | | 1 | 1/2 Offset tailpiece .50 |
| | | | | 1/2 | Hr. Town Shovel @6.50 3.25 |
| | | | | | 45.04 |
| | | | | 6-19-61 | Bill sent 5.61 |

TOWN OF LEXINGTON — BOARD OF PUBLIC WORKS

WATER DIVISION

Sketch of Service Here

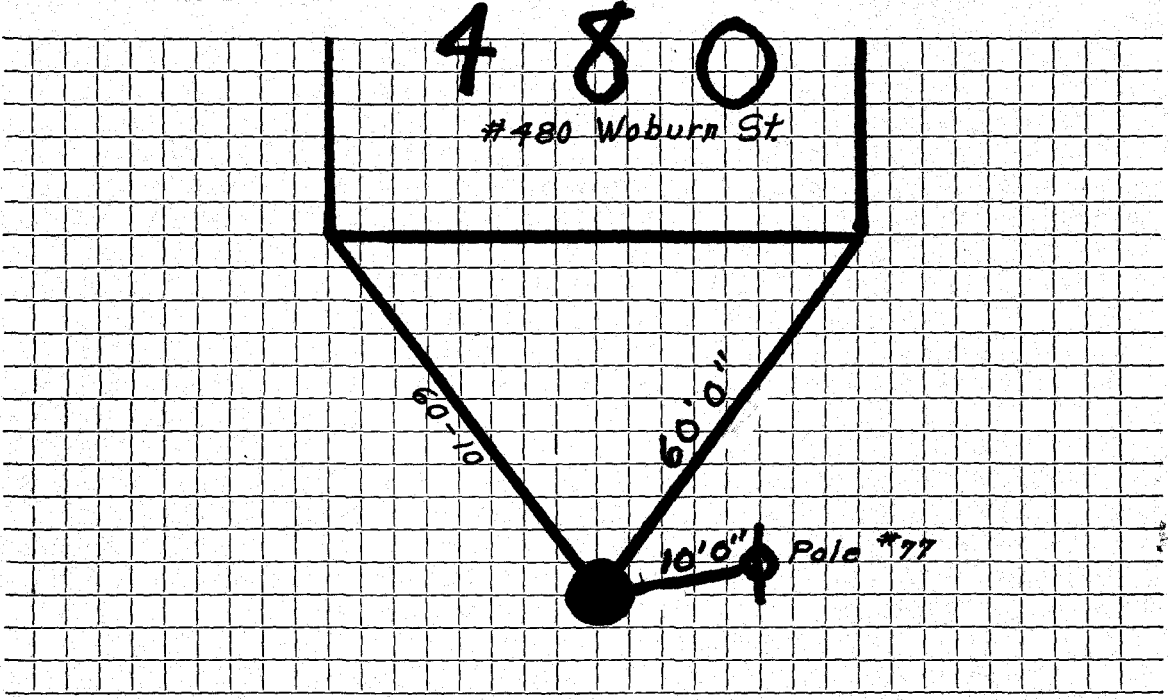

Connection made in Street. Work completed

Remarks:
.....
.....