

WATER SERVICE RECORD

Name Miles Turner

Service No. 188

Address 509 Woburn St.

Location Lexington, Mass.


~~Request for~~ New Service *Com. 10/1/51*

Date	Material	Amount	Total	Date	Amount
8-23-51	Labor	5 74	5 74	8-13-51	Deposited 125 10
	10% Overhead		57	10-1-51	Refunded 40 12
	130'-3/4" Copper Tubing @.326		42 38		84 88
	1-3/4" Cx 1/2" I.W.H. S&W		4 00		No Charge
	2-3/4" Cx 3/4" C Union (3 pts)		3 74	8-23-51	Labor 5 74
	4 Hrs. Littlefield Shovel		28 00		10'-3/4" Copper Tubing @.326 3 26
	1 Hr. Trucking		75		1-3/4" C. Corp-Cock 4 33
			84 88		1-3/4" Cx 3/4" C Curb-Cock 4 67
					1 Box & Rod 4 68
					2-1/2" Straight Tail Pieces 1 00
					1 Hr. Littlefield Shovel 7 00
					1 Hr. Trucking 75
					31 43

DATE _____

TOWN OF LEXINGTON — BOARD OF PUBLIC WORKS
WATER DIVISION

Sketch of Service Here

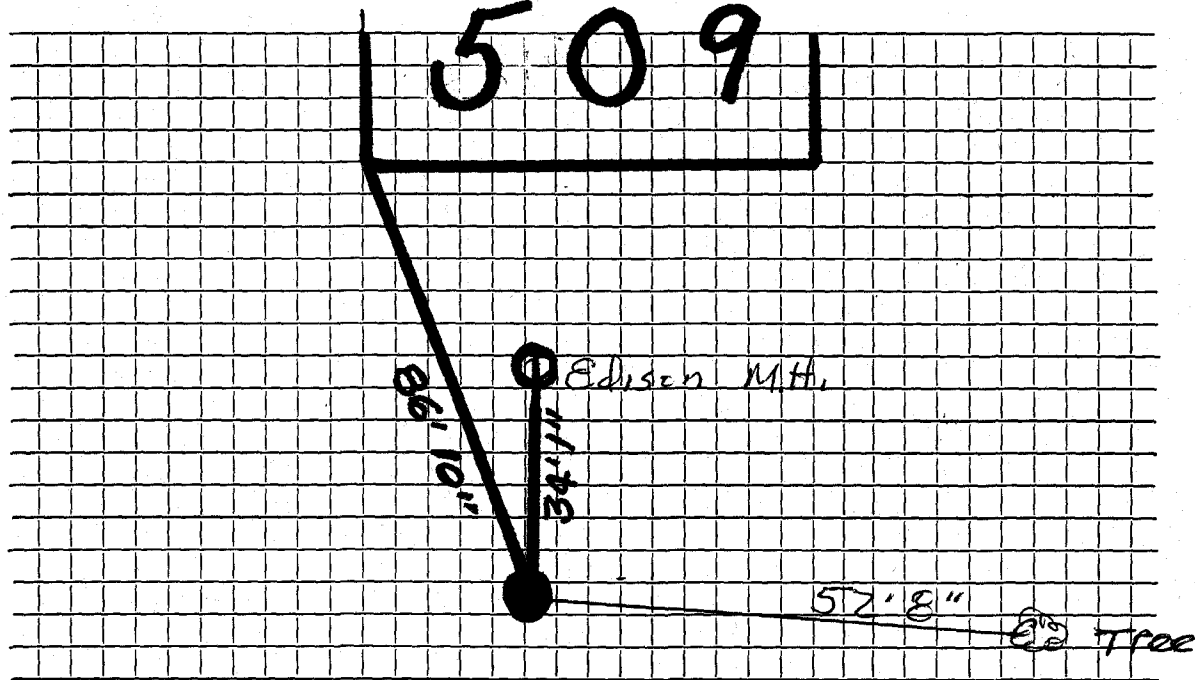

Connection made in Street. Work completed

Remarks:

.....
.....