

WATER SERVICE RECORD

2720

Name Mahoney & DeVincent Bld.

Service No. 221

Address 510 Woburn Street

Location

~~Repair~~ ~~Renewal~~ New Service


Conn 12-31-60

Date	Material	Amount	Total	Date		Amount
10-8-60	Labor	5.80		10-7-60	Deposit	75.00
	10% O.H.	.58	6.38	12-31-60	Retained	6.45
50	3/4" Copper tubing @.42		21.00			68.55
1	3/4" C x 1/2 I.W.H. Stop & Waste		6.17		NON CHARGE	
1	hr. Trucking @3.00		3.00	12-20-60	Labor	92.73
32	x 3 Patch		32.00	12-21-60	Labor	25.28
			68.55		29' 3/4" Copper tubing @.42	12.18
					1 3/4" C Corp Cock	4.91
					1 3/4" C Curb Cock	6.28
					1 Box & Rod	4.90
					1 1/2 Straight tailpiece	.50
					1 1/2 Offset tailpiece	.50
					1 hr. Trucking @3.00	3.00
					3 hrs. Compressor @3.00	9.00
					2 hrs. Town Shovel @6.50	13.00
						172.28

TOWN OF LEXINGTON — BOARD OF PUBLIC WORKS

WATER DIVISION

Sketch of Service Here

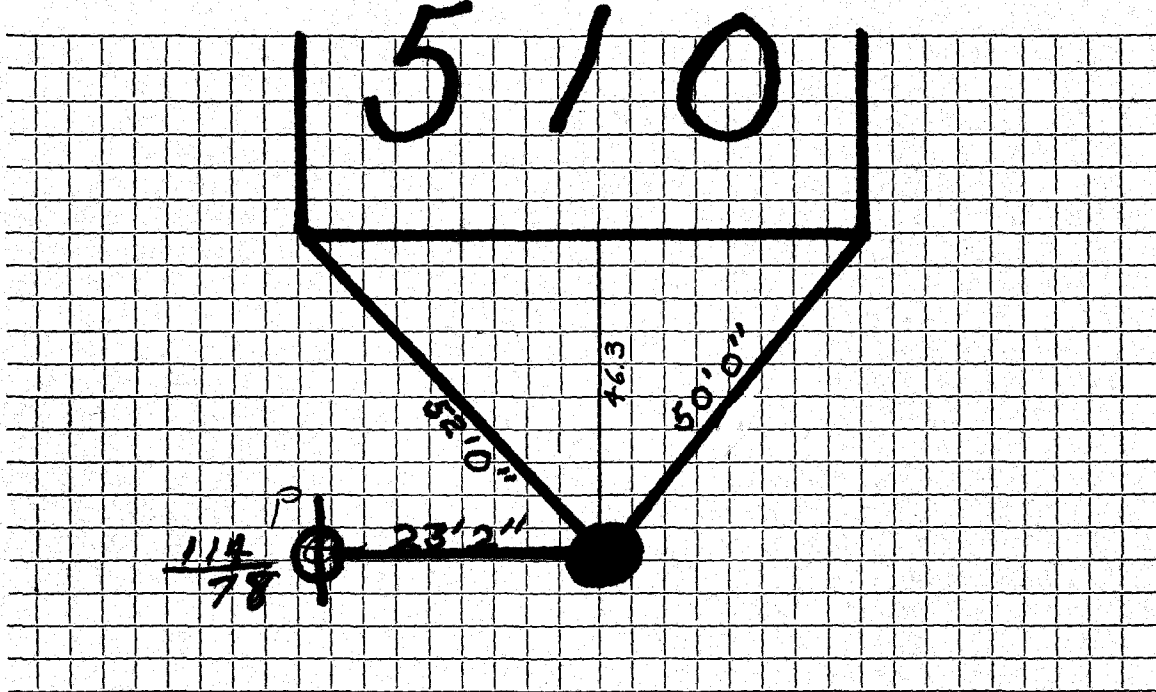

Connection made in Street. Work completed

Remarks:

.....

.....