


DATE _____

TOWN OF LEXINGTON — BOARD OF PUBLIC WORKS
WATER DIVISION

Sketch of Service Here

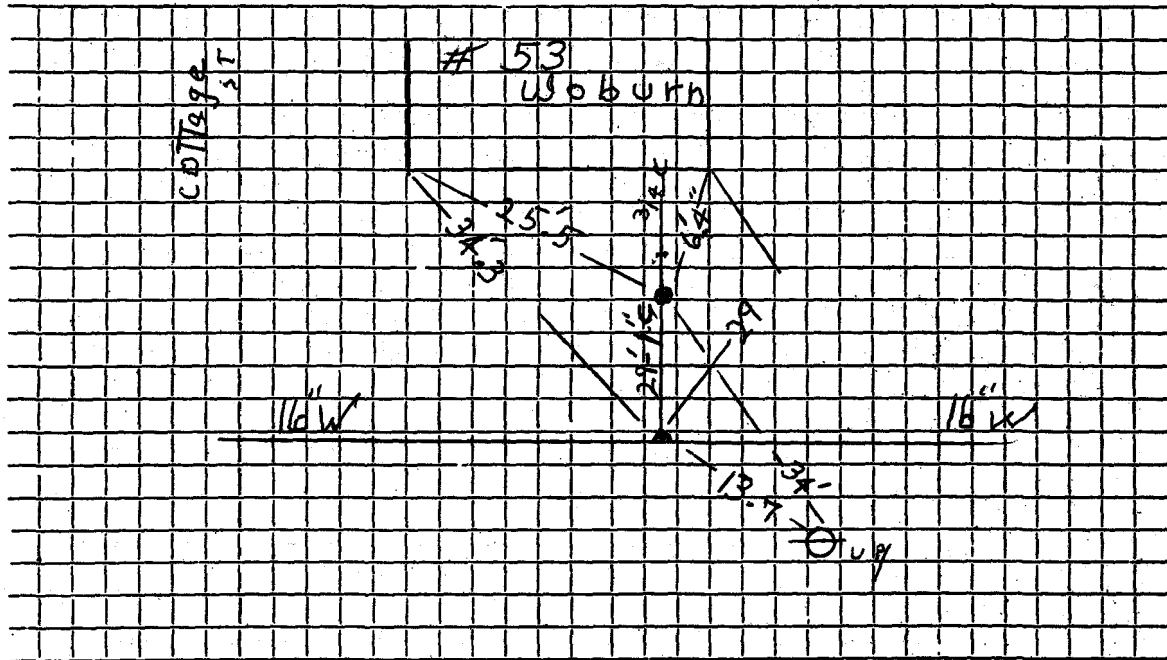

Connection made in Street. Work completed 9/17/07 DeFlice

Remarks:
.....
.....