


DATE 9/13/19

TOWN OF LEXINGTON — BOARD OF PUBLIC WORKS
WATER DIVISION

Sketch of Service Here

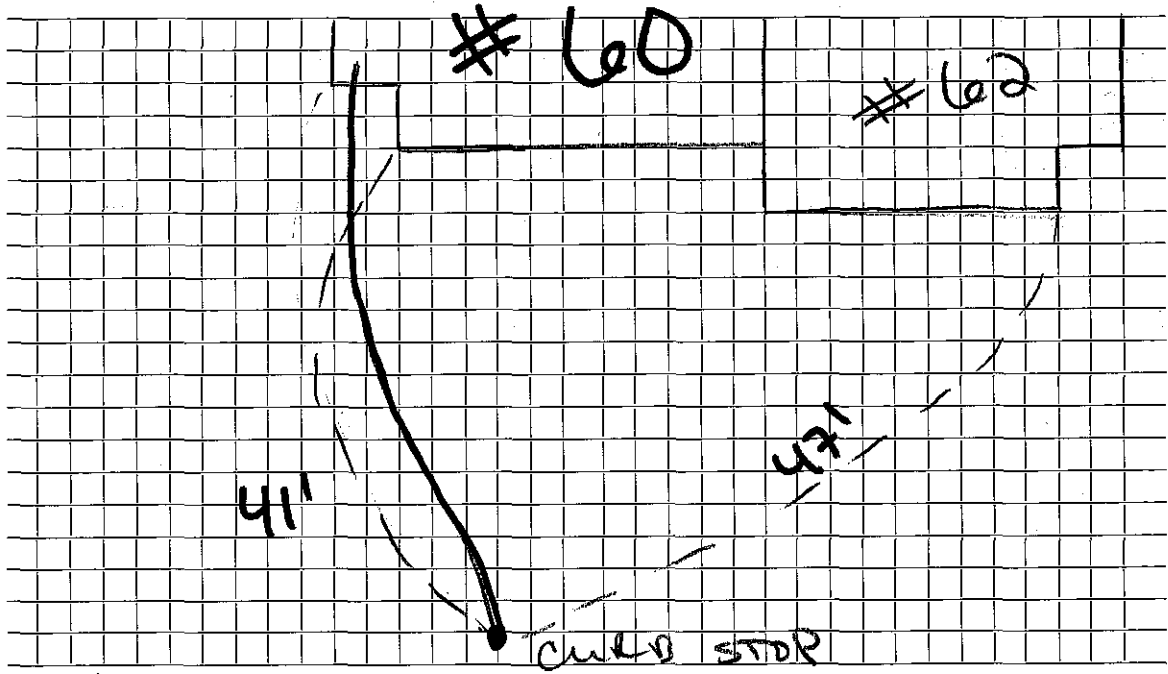

Connection made in Woburn Street. Work completed

Remarks: curb stop in sidewalk