


DATE 9/13/2019

TOWN OF LEXINGTON — BOARD OF PUBLIC WORKS

WATER DIVISION

Sketch of Service Here

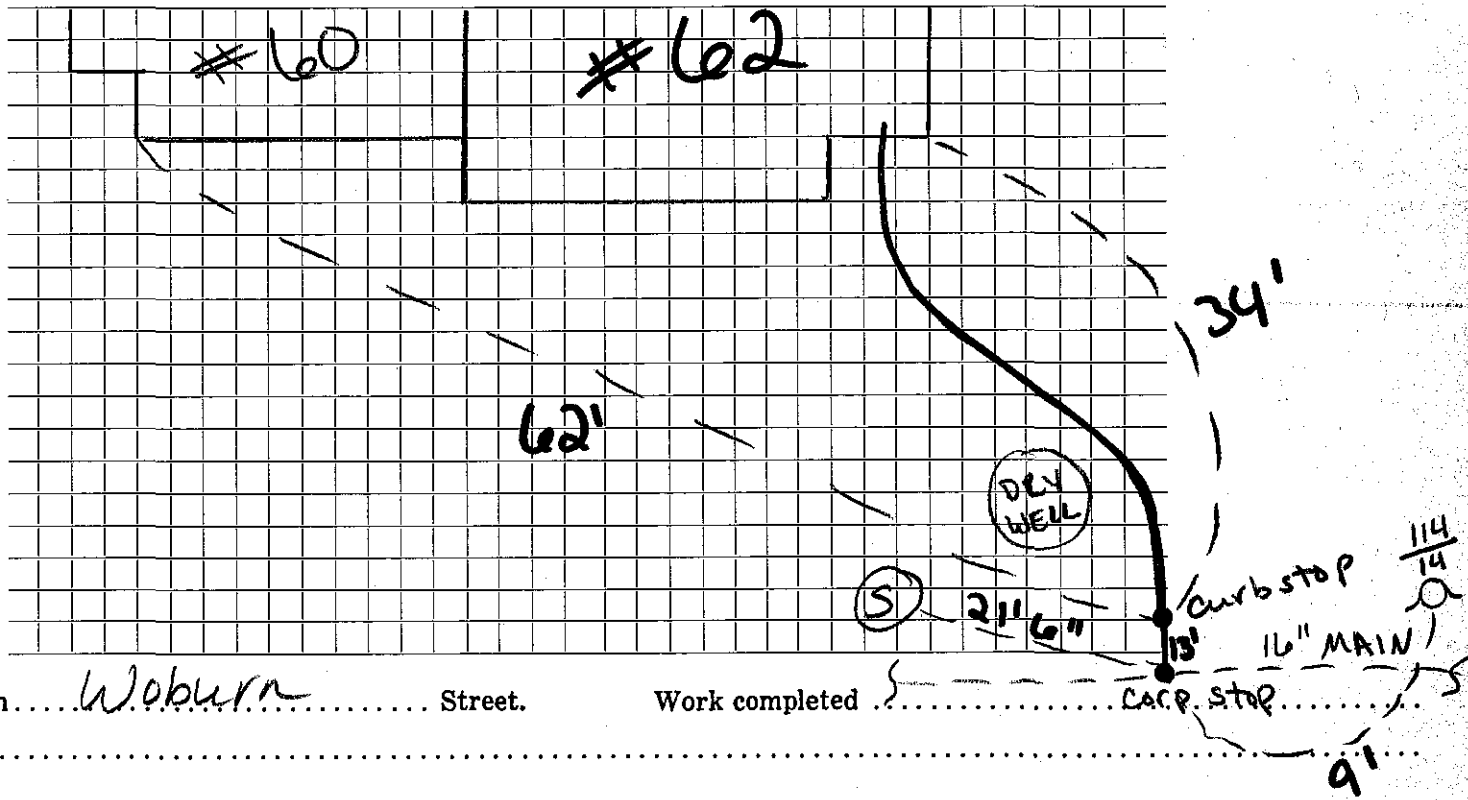

Connection made in Woburn Street.

Work completed 9/13/2019

Remarks: