

WATER SERVICE RECORD

Name *Charles Vail*

Service No.

Address *64 Woburn Street*

Location

LOT 241

~~Repair - Renewal~~ - New Service *Valeri #0277*


Date		Material	Amount	Total	Date		Amount
<i>9/21/93</i>	<i>54'</i>	<i>1" Copper</i>					
		<i>1" Valve</i>					
		<i>Insulated 4' down on ledge</i>					
						<i>OUTSIDE</i>	
					<i>9/21/93</i>	<i>13.9'</i>	
						<i>1" Copper</i>	
						<i>1" Corp</i>	
						<i>1" Curb</i>	
						<i>Buffalo Box</i>	
						<i>Insulated curb to main</i>	

TOWN OF LEXINGTON — BOARD OF PUBLIC WORKS

WATER DIVISION

Sketch of Service Here

64

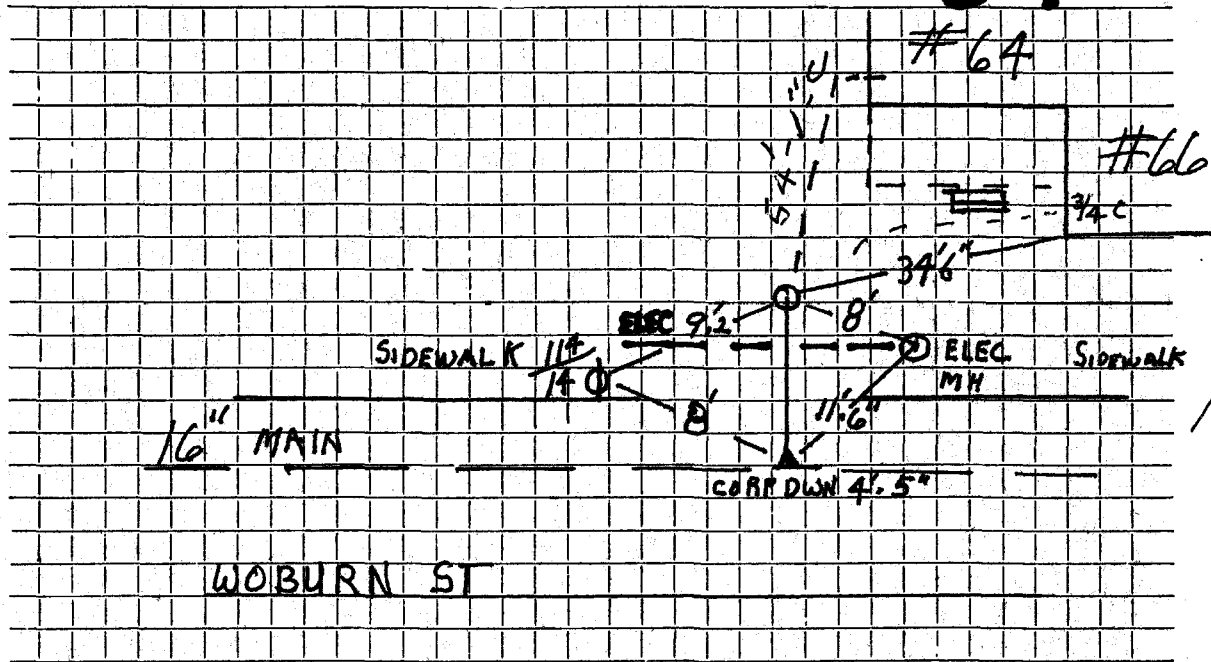

out
14'-1" C

Connection made in WOBURN ST. 16" MAIN Street. Work completed

Remarks: COPPER FOR BOTH CONDO'S GOES UNDER DUCT LINE 4' DWN