


DATE _____

TOWN OF LEXINGTON — BOARD OF PUBLIC WORKS

WATER DIVISION

Sketch of Service Here

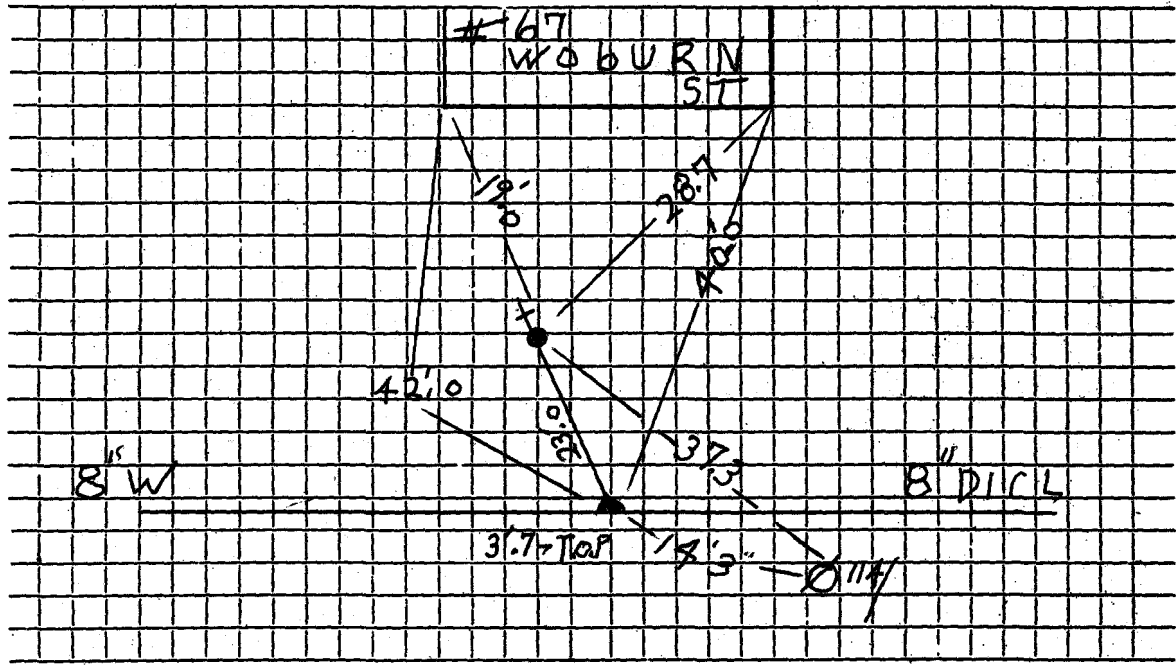

Connection made in Street. Work completed *SEP 13-07 Def. l.c.e.*.....

Remarks:

.....

.....