


DATE _____

TOWN OF LEXINGTON — BOARD OF PUBLIC WORKS

WATER DIVISION

Sketch of Service Here

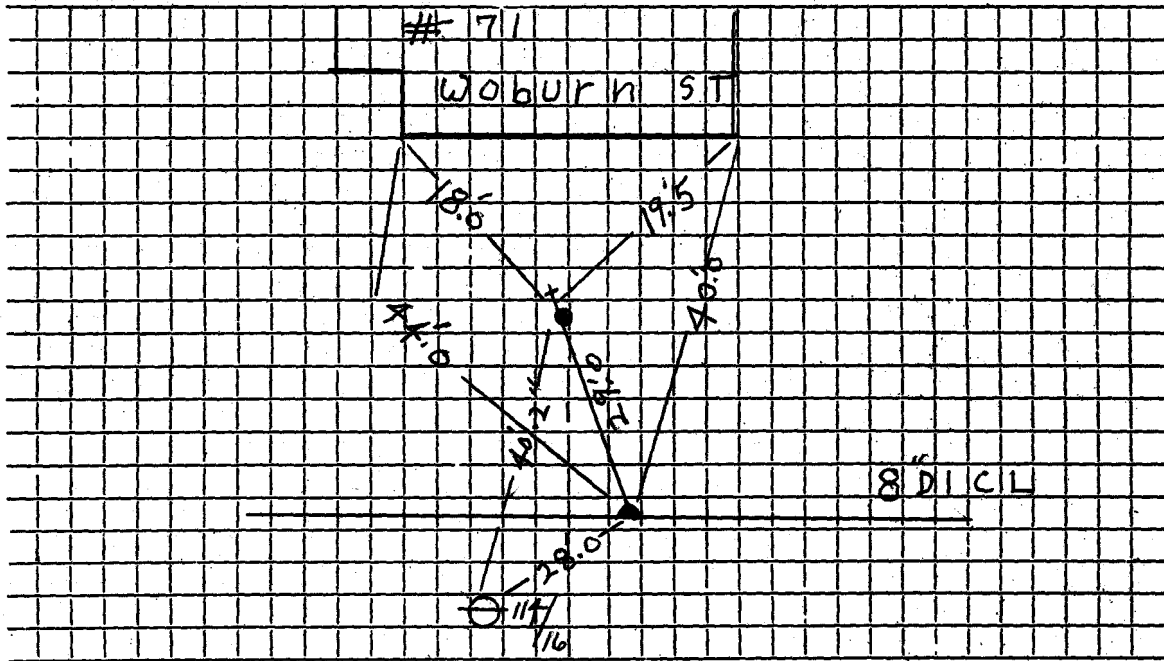


Connection made in Street. Work completed 9/13/07 D.S.F.L.I.C.E.

Remarks:

.....

.....

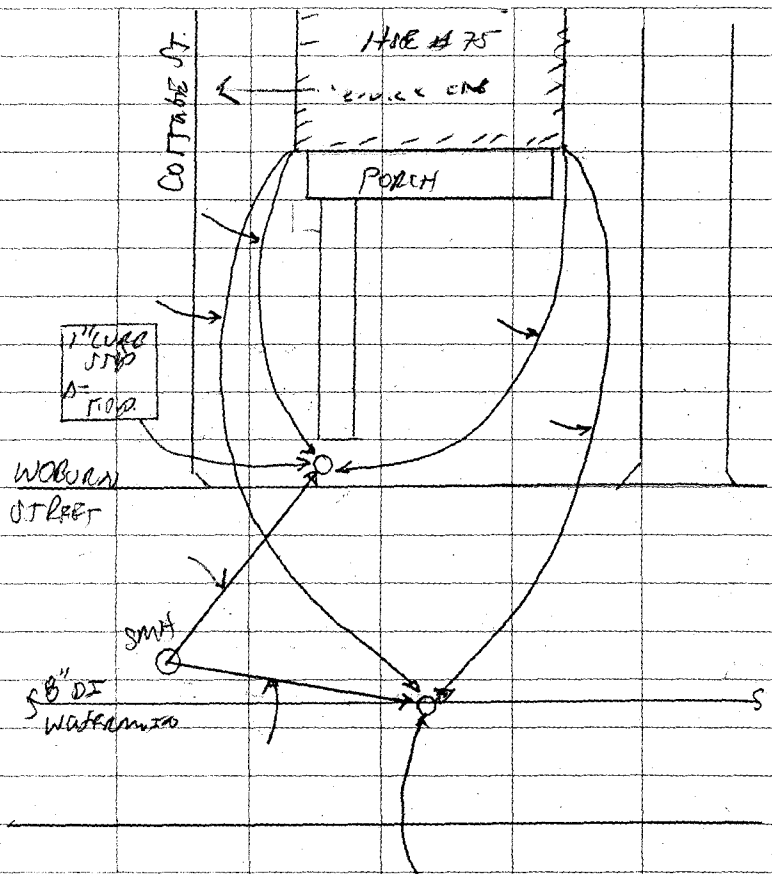

1" COPPER STOP
 0" TOP

1" COPPER STOP
 0" TOP

1" COPPER PIPE = ϕ
 1" COPPER STOP = 1 EA
 1" COPPER STOP = ϕ EA
 COPPER BOX = ϕ EA

* 3/4" LEAD FOUND + DRY -
 INSIDE HOUSE COPPER PIPE FOUND
 COTTAGE ST (3/4" ϕ)