

WATER SERVICE RECORD

Name \_\_\_\_\_

Service No. \_\_\_\_\_

Address 78 Woburn Street

Location \_\_\_\_\_

Lot 245

~~REPAIR/RENEWAL~~ - New Service

SEE


Date	Material	Amount	Total	Date	Amount
				Taped-Mantley CT	
				<u>NON CHARGE</u>	
				11/18/54 Labor	25 04
				25' - 3/4" copper tubing @ .35	8 75
				1 - 3/4" C. adapter	1 95
				1 - 3/4" C. curb-cock	4 67
				1 box and rod	3 90
				3 hrs. Littlefield shovel @ 7.50	22 50
				1 hr. trucking	75
					67 56

DATE \_\_\_\_\_

TOWN OF LEXINGTON — BOARD OF PUBLIC WORKS

WATER DIVISION

Sketch of Service Here

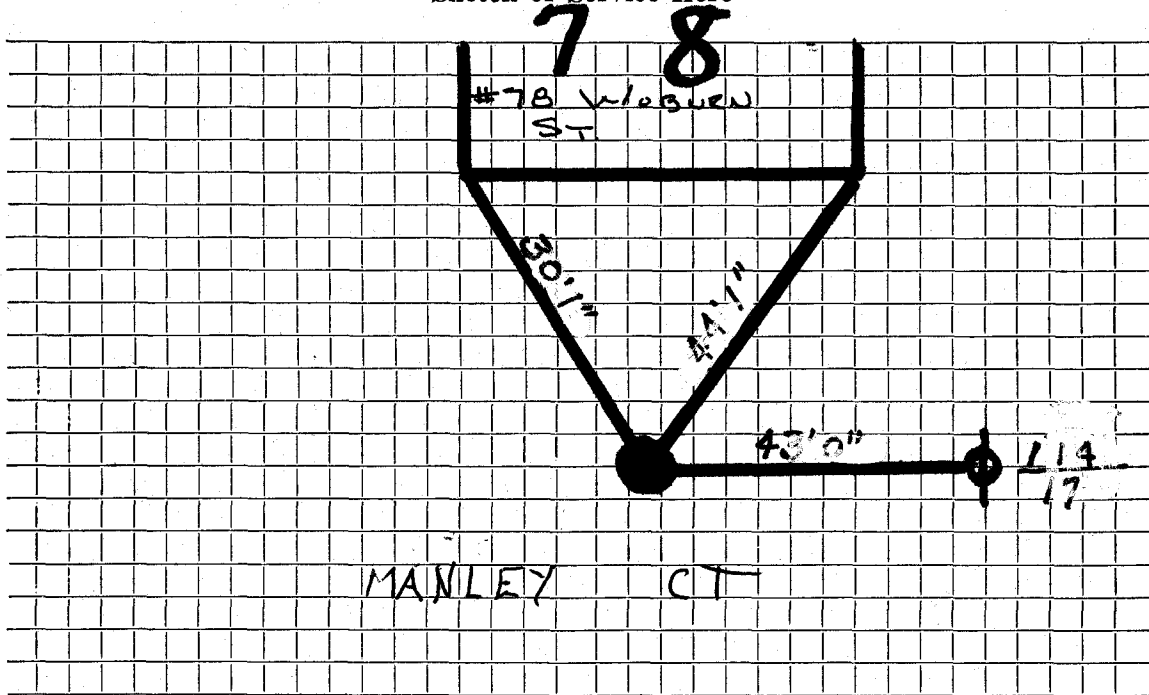

Connection made in ..... Street. Work completed .....

Remarks: Service Tap on Manley Ct