




DATE \_\_\_\_\_

TOWN OF LEXINGTON — BOARD OF PUBLIC WORKS

WATER DIVISION

Sketch of Service Here

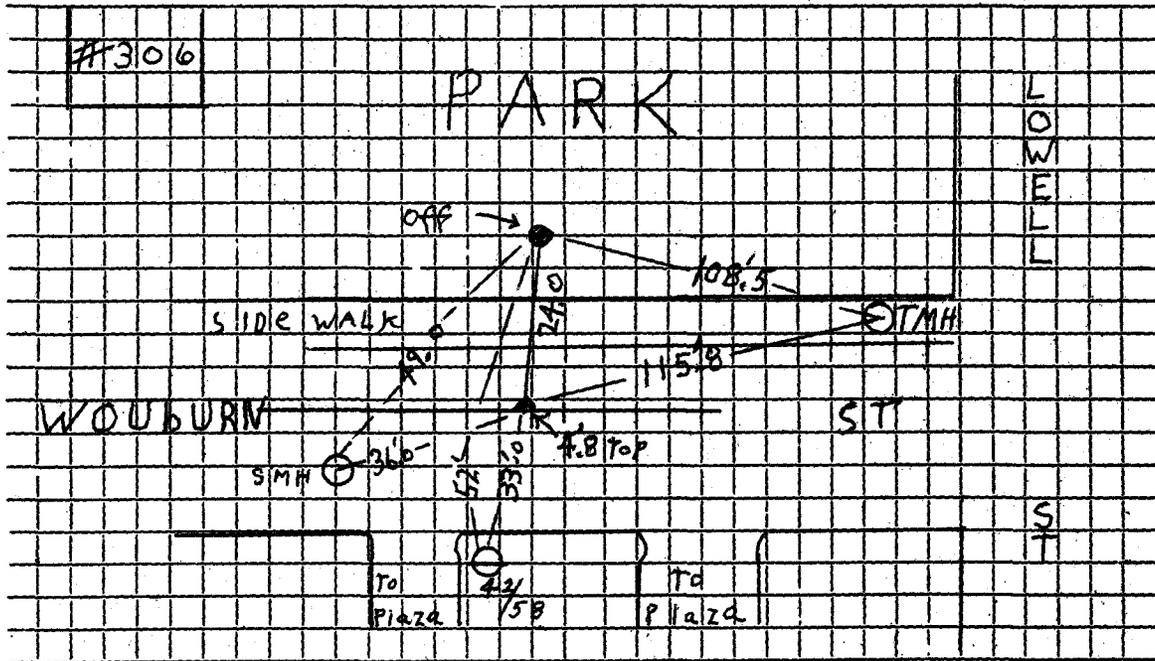

Connection made in \_\_\_\_\_ Street.

Work completed 7/25/07 Deflice

Remarks: Curb STOP IN OFF POSITION